



FALL CREEK REGIONAL WASTE DISTRICT

9378 S. 650 West PO Box 59  
Pendleton, IN 46064-0059 778-7544

add order  
on file

22-27123.00

March 2<sup>ND</sup>

APPLICATION FOR SEWER PERMIT

No 2981

Date 12/6/00

Permit Void 90 days from Date of Issuance

Owner Name Keri Kraay Craig Brunnemer

Property Address 6052 S. Red Fox Road

Lot # 79 HHE P.O. Box \_\_\_\_\_

Town Pendleton, IN Zip Code 46064

Phone (765) 644-6566 EXT. 37 City Water \_\_\_\_\_ Well ☒

\$ 400.00 Tap on Fee Paid transferred from

\$ \_\_\_\_\_ Inspection fee paid permit #2880

Application is hereby made for connection to the Fall Creek Regional Waste District Sewer System for the above listed property - Permit Type: Residential ☒, Commercial \_\_\_\_\_, Industrial \_\_\_\_\_, or Governmental/Institutional \_\_\_\_\_. User Information \_\_\_\_\_.

All workmanship and materials shall conform to the standards of the District Ordinance as described in Ordinance 84-2 and 84-3 as amended. Acceptance and approval must be made by the District inspector or his duly authorized representative before backfilling and final connection is made to the main sewer lines. Any violation of applicable regulations will cause all lines and appurtenances in violation to be removed and replaced at the owners expense.

The Fall Creek Regional Waste District is responsible for the inspection, approval of materials, and installation techniques only. All costs for materials and installation and any liabilities resulting from same is the sole responsibility of the property owner.

I have read and fully understand the above provisions and agree to comply by said provisions.

Hallmark Homes Lilly Wilson  
APPLICANT(S) SIGNATURE

INSPECTOR B

Date inspected 12-5-00 Approved ☒ Rejected \_\_\_\_\_

Reason for rejection \_\_\_\_\_

Date reinspected \_\_\_\_\_ Approved \_\_\_\_\_ Rejected \_\_\_\_\_

Notes:

Size Pipe 6"

Type Pipe PVC

Basement Yes \_\_\_\_\_ No ☒

Sump Pump Yes \_\_\_\_\_ No ☒

Downspout to Ground Yes ☒ No \_\_\_\_\_


Septic Tank Pumped & filled Yes \_\_\_\_\_ No ☒

Contractor Mark Smith

Special Conditions \_\_\_\_\_

Existing Home \_\_\_\_\_

New Construction ☒

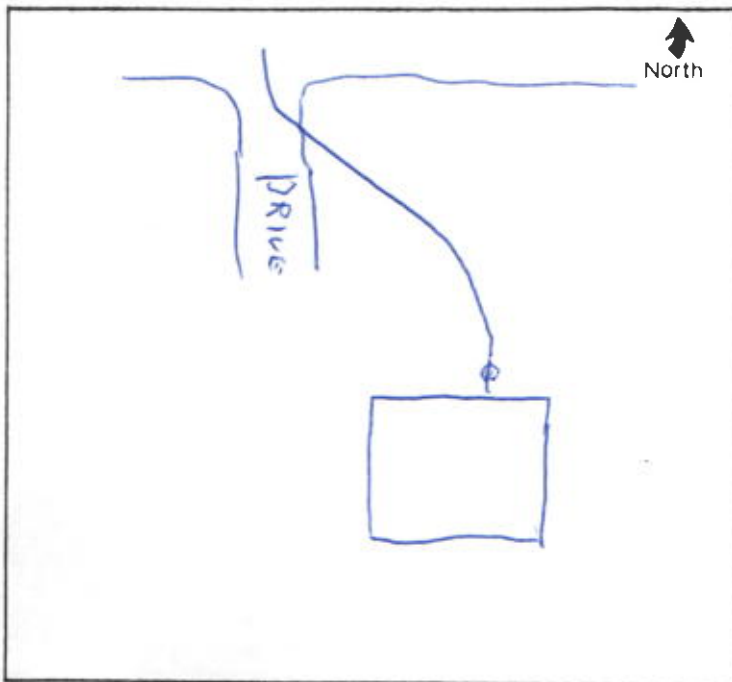



# FALL CREEK REGIONAL WASTE DISTRICT

9378 S. 650 West PO Box 59  
Pendleton, IN 46064-0059 778-7544

## APPLICATION FOR SEWER PERMIT

Nº 2880

Date

9/8/00

Permit Void 90 days from Date of Issuance

Owner Name

Keri Kraay

Property Address

6052 S Red Fox Rd Hickory Hills East

Lot #

75

P.O. Box

Town

IN Zip Code

Phone

City Water

Well

\$

400.00

Tap on Fee Paid

\$

Inspection fee paid

Application is hereby made for connection to the Fall Creek Regional Waste District Sewer System for the above listed property - Permit Type: Residential ☒, Commercial ☐, Industrial ☐, or Governmental/Institutional ☐. User Information

All workmanship and materials shall conform to the standards of the District Ordinance as described in Ordinance 84-2 and 84-3 as amended. Acceptance and approval must be made by the District inspector or his duly authorized representative before backfilling and final connection is made to the main sewer lines. Any violation of applicable regulations will cause all lines and appurtenances in violation to be removed and replaced at the owners expense.

The Fall Creek Regional Waste District is responsible for the inspection, approval of materials, and installation techniques only. All costs for materials and installation and any liabilities resulting from same is the sole responsibility of the property owner.

I have read and fully understand the above provisions and agree to comply by said provisions.

Hallmark Homes Lily Wilson

APPLICANT(S) SIGNATURE

INSPECTOR

Date inspected

Approved

Rejected

Reason for rejection

Date reinspected

Approved

Rejected

Notes:

Size Pipe

Type Pipe

Basement Yes

No

Sump Pump Yes

No

Downspout to Ground Yes

No

Septic Tank Pumped & filled Yes

No

Contractor

Special Conditions

Existing Home

New Construction



HALLMARK HOMES NORTHEAST, INC.

433 E. 53RD STREET  
ANDERSON, IN 46013  
(317) 858-0030 OR  
(765) 644-6566

NATIONAL CITY BANK, INDIANA  
INDIANAPOLIS, IN 46255  
20-6/740

5848

09/08/2000


PAY TO THE ORDER OF Fall Creek Regional Waste

\$ \*\*400.00

Four Hundred and 00/100\*\*\*\*\*

Fall Creek Regional Waste  
P.O. Box 159  
Pendleton, IN 46064-0059

DOLLARS  
Security features  
included.  
Details on back.

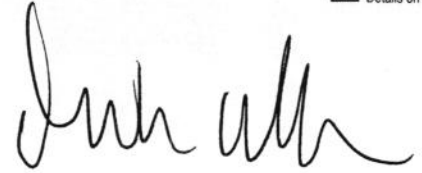

MEMO \_\_\_\_\_

⑈005848⑈ ⑆074000065⑆ 7730155731⑈

644-6566

