



FALL CREEK REGIONAL WASTE DISTRICT

Box 44, Pendleton, Indiana 46064

1-000033500

Nº 000216

APPLICATION FOR SEWER PERMIT

Permit No. _____ Date 9-30-85
Permit Void 90 days from Date of Issuance
Owner Name Jerome Roberts
Property Address 605 Jones Street
Lot # _____ P.O. Box 272
Town Laurels, IN Zip Code 46048
Phone 48527393 Water Meter 11
\$ 150.00 Tap on Fee Paid
\$ 25.00 Inspection fee paid

Application is hereby made for connection to the Fall Creek Regional Waste District Sewer System for the above listed property - Permit Type: Residential ☒, Commercial _____, Industrial _____, or Governmental/Institutional _____. User Information _____.

All workmanship and materials shall conform to the standards of the District Ordinance as described in Ordinance 84-2 and 84-3 as amended. Acceptance and approval must be made by the District inspector or his duly authorized representative before backfilling and final connection is made to the main sewer lines. Any violation of applicable regulations will cause all lines and appurtenances in violation to be removed and replaced at the owners expense.

The Fall Creek Regional Waste District is responsible for the inspection, approval of materials, and installation techniques only. All costs for materials and installation and any liabilities resulting from same is the sole responsibility of the property owner.

I have read and fully understand the above provisions and agree to comply by said provisions.


X Jerome Roberts
APPLICANT(S) SIGNATURE

INSPECTOR Tm

Date inspected 10-10-85 Approved ☒ Rejected _____
Reason for rejection _____

Date reinspected _____ Approved _____ Rejected _____

Notes:
Size Pipe 6"
Type Pipe PVC
Basement Yes _____ No ☒
Sump Pump Yes _____ No ☒
Downspout to Ground Yes ☒ No _____
Septic Tank Pumped & filled Yes ☒ No _____
Contractor Fisk Sanitation
Special Conditions _____

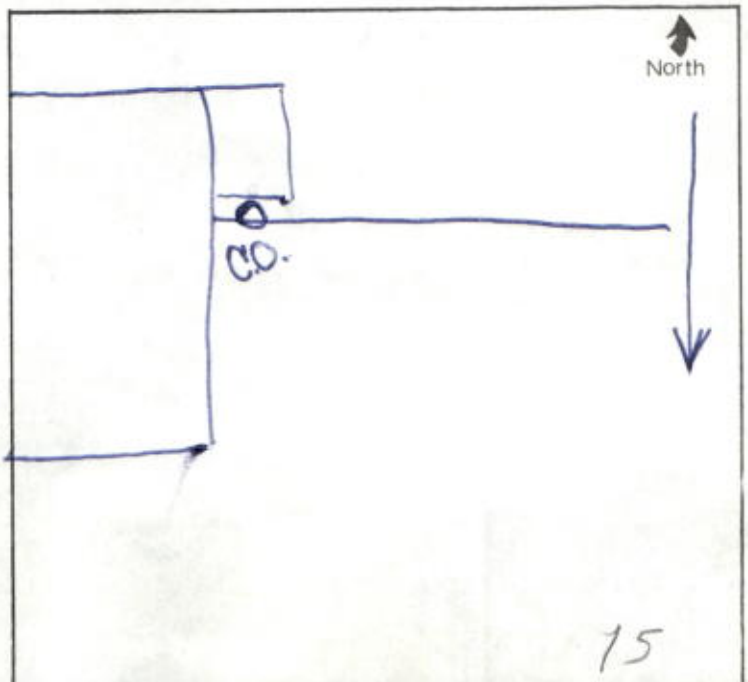

FALL CREEK REGIONAL WASTE DISTRICT

For all handling, loading, unloading



NO. 000518

28-03-0

at road A corner
tenth and 20th

891318
1200
32


Handwritten notes and signatures in the middle section of the document.

Handwritten notes and signatures in the middle section of the document.

Handwritten notes and signatures in the middle section of the document.

ANT

2000

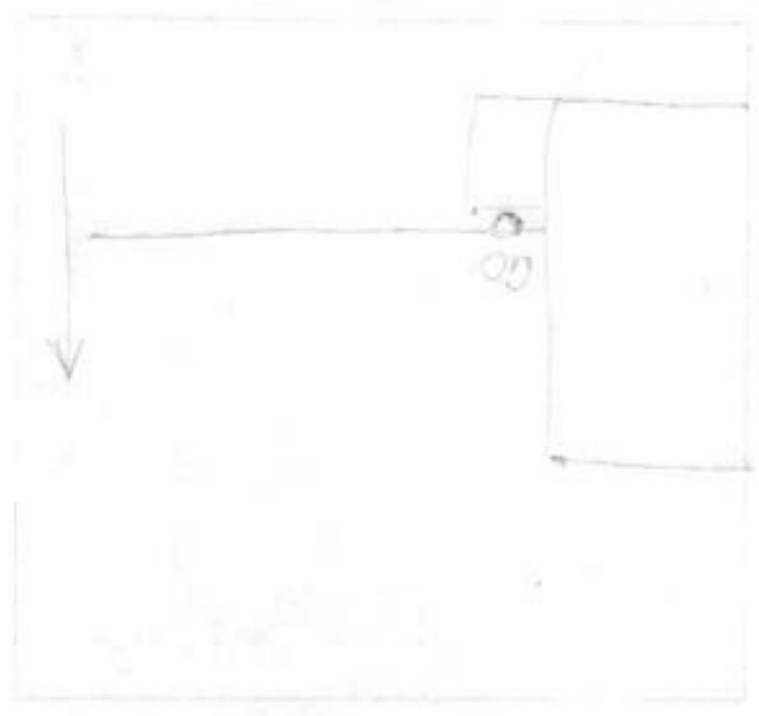

Handwritten notes and signatures in the bottom right section of the document.