

26-08610.00

No 5058

FALL CREEK REGIONAL WASTE DISTRICT

9378 S 650 WEST, P.O. BOX 59, PENDLETON, IN 46064

765-778-7544

AGREEMENT FOR SANITARY SEWER SERVICE

This Agreement made and entered into this 20th day of November, 2003, between FALL CREEK REGIONAL WASTE DISTRICT ("District") and John E Robert Plawewski ("Applicant") regarding the provision of sanitary sewer service, and the assignment of capacity in, and connection to, the District's facilities for the premises located at Lot #32 Foster Branch Ridge 6071 Foster Ridge Lane

NOW THEREFORE, the parties, in consideration of the mutual promises set out in this Agreement, the receipt and sufficiency of which is hereby acknowledged, agree as follows:

1. The Applicant agrees that all workmanship and materials shall conform to all District ordinances and the District's construction standards. District must accept and approve all work and materials before backfilling and final connection is made to the sewer mains. Any violation of this provision will cause all lines and appurtenances in violation to be removed and replaced at the Applicant's expense.

2. The District shall have the right to enter upon the Applicant's premises at all reasonable times to inspect, repair, or replace any equipment used in connection with the District's service or which has an impact on said service.

3. The Applicant shall be responsible for all monthly user rates, capacity charges, and tap fees. The failure to pay any rate charge or fee may result in a lien against the property and/or the termination of service to the property, the cost of which will be borne by Applicant, including, but not limited to, all attorney's fees and collection costs.

4. The District shall not be responsible for any damages as a result of any failure to supply service unless said damages are due to default, neglect or culpability on the part of the District.

5. If there is an available sanitary sewer within three hundred (300) feet of the property line, the property owner shall be required to connect to the District's sanitary sewer system.

6. The Applicant and District agree that the provision of sanitary sewer service touches and concerns the property and the terms of this Agreement bind the District and Applicant and their heirs, executors, administrators, personal representatives, successors, agents, attorneys, assigns, designees, and transferees.

The parties hereto have read and fully understand the above provisions and agree to comply with said provisions.

FALL CREEK REGIONAL WASTE DISTRICT

Signature

STATE OF INDIANA)
) SS:
COUNTY OF MADISON)

APPLICANT

Signature

SUBSCRIBED and sworn to before me this 20th day of November, 2003.

My Commission Expires:

4-29-09

Signature

Printed

Notary Public
Resident of Madison County

INSPECTOR JB DATE INSPECTED 4-20-04 APPROVED ✓ REJECTED _____

REASON FOR REJECTION _____

DATE REINSPECTED _____ APPROVED _____ REJECTED _____

NOTES:

SIZE PIPE 4" - 1 1/4" TYPE PIPE PVC

BASEMENT YES ✓ NO _____

SUMP PUMP YES ✓ NO _____

DOWNSPOUT TO GROUND YES ✓ NO _____


SEPTIC TANK PUMPED & FILLED YES _____ NO ✓

CONTRACTOR Dan Foster

SPECIAL CONDITIONS _____

EXISTING HOME _____

NEW CONSTRUCTION ✓

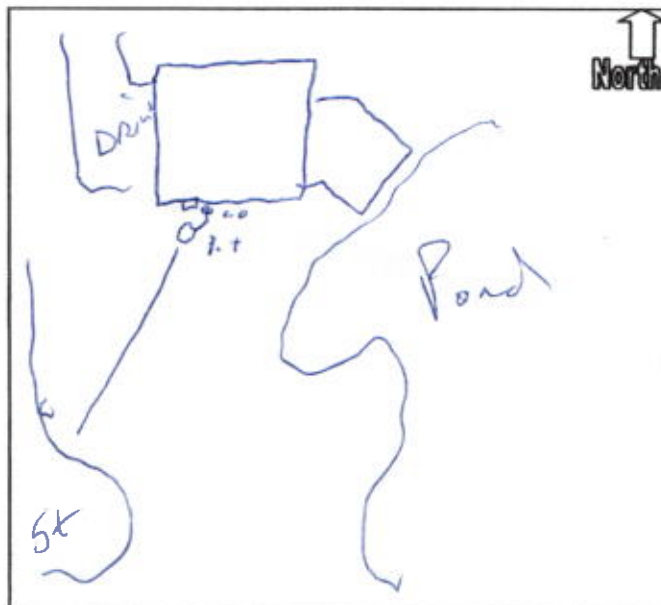

CAMPBELL CUSTOM HOMES, INC.
6103 W. FOSTER RIDGE LANE
PENDLETON, IN 46064

71-553/749
7005105

5425

DATE

11/20/2003

PAY TO THE
ORDER OF

FALL CREEK REGIONAL MSYS 2635.⁰⁰
Twenty Six Hundred Thirty Five ⁰⁰/₁₀₀ DOLLARS



Madison
Community Bank

MEMO

LOT 32 PLANNED SCOTT RAYMOND

⑆074905539⑆ 700 510 511 5425

SIGNATURE PLUMBING CO., INC. 06-00

PH. 765-533-2287

P.O. BOX 69

MARKLEVILLE, IN 46056-0069

71-553/749
8946310

2650

DATE 4-20-04

PAY TO THE
ORDER OF

FCRWD

\$ 1549.72

Fifteen hundred forty nine 72/100

DOLLARS

Security Features
Included
Details on Back.



Madison
Community Bank

MEMO

Lot 32

[Signature]

MP

⑆074905539⑆ 894 631 0⑈ 2650