



FALL CREEK REGIONAL WASTE DISTRICT

9378 S. 650 West PO Box 59
Pendleton, IN 46064-0059 778-7544

add order
on file

22-27098.00

Riffey Builders - spec home
5169 S 525 W

APPLICATION FOR SEWER PERMIT

No 2251

Date 8/28/95

Permit Void 90 days from Date of Issuance

Owner Name Sheldon Swank

Property Address 6084 S. Woodchuck

Lot # 73 P.O. Box

Town Pendleton, IN Zip Code 46064

Phone City Water Well ☒

\$ 700.00 Tap on Fee Paid

\$ 25.00 Inspection fee paid

Application is hereby made for connection to the Fall Creek Regional Waste District Sewer System for the above listed property - Permit Type: Residential ☒, Commercial ☐, Industrial ☐, or Governmental/Institutional ☐. User Information

All workmanship and materials shall conform to the standards of the District Ordinance as described in Ordinance 84-2 and 84-3 as amended. Acceptance and approval must be made by the District inspector or his duly authorized representative before backfilling and final connection is made to the main sewer lines. Any violation of applicable regulations will cause all lines and appurtenances in violation to be removed and replaced at the owners expense.

The Fall Creek Regional Waste District is responsible for the inspection, approval of materials, and installation techniques only. All costs for materials and installation and any liabilities resulting from same is the sole responsibility of the property owner.

I have read and fully understand the above provisions and agree to comply by said provisions.

Harold E. Riffey, pres
APPLICANT(S) SIGNATURE

INSPECTOR Tim

Date inspected 9-13-95 Approved ☒ Rejected ☐

Reason for rejection

Date reinspected Approved Rejected

Notes:

Size Pipe 6"

Type Pipe SDR 35

Basement Yes No ☒

Sump Pump Yes No ☒

Downspout to Ground Yes ☒ No

Septic Tank Pumped & filled Yes No


Contractor Bolton Construction

Special Conditions

Riffey Builders

Existing Home

New Construction ☒

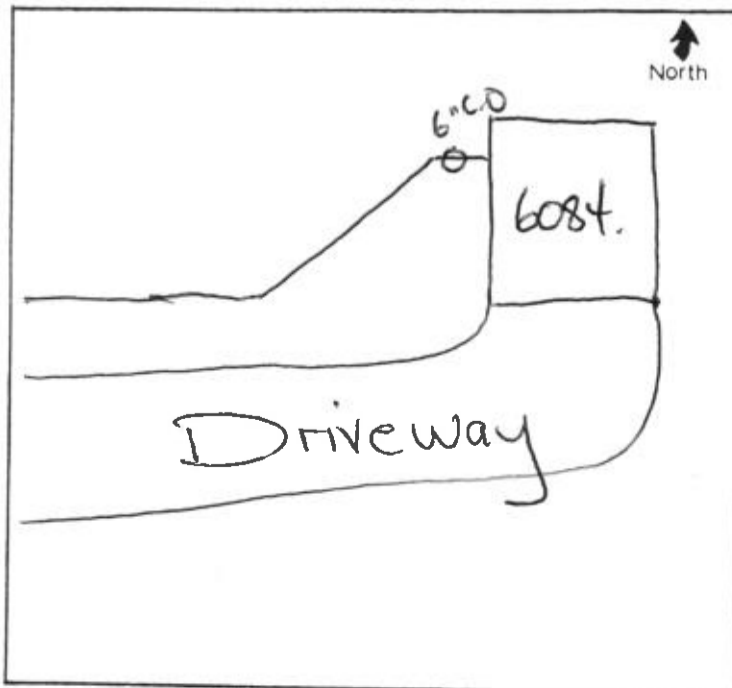

RIFFEY BUILDERS, INC.

5169 S. 525 W.
PENDLETON, IN 46064

358

71-538/749

PAY TO THE
ORDER OF

8-28 1995
Fall Creek Regional Waste.

\$ 2175.⁰⁰

Two Thousand One Hundred Seventy Five DOLLARS



COMMUNITY
BANK

LAPEL, INDIANA 46051

MEMO

Seve taps
Lot # 24, 73, 91

Harold E Riffe ^{MP} pres

⑆074905380⑆ 003⑈056⑈2⑈ 0358

SAFETY PAPER