

Gidw.


PROJECT Phase II SHEET _____ OF _____

SUBJECT _____ DATE 4-13-18

JOB NO. 4447

BY Atlas

609 W. Taylor

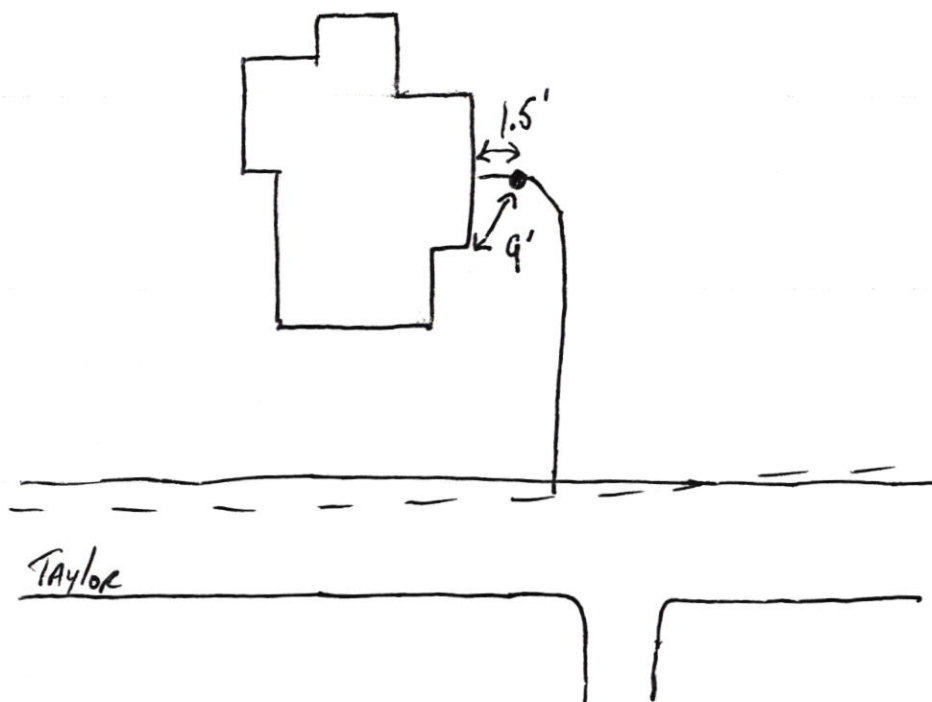

609 Taylor

SHP
Phase II

4.20.18

