

add order
on file



FALL CREEK REGIONAL WASTE DISTRICT
9378 S. 650 West PO Box 59
Pendleton, IN 46064-0059 778-7544

22-27310.00

APPLICATION FOR SEWER PERMIT

Nº 2796

Date 6/6/00

Permit Void 90 days from Date of Issuance

Owner Name Jeffrey Helping

Property Address 6102 S. Woodchuck Drive

Lot # 127, HHE P.O. Box _____

Town Pendleton, IN Zip Code 46064

Phone _____ City Water _____ Well ☒

\$ 400.00 Tap on Fee Paid

\$ _____ Inspection fee paid

Application is hereby made for connection to the Fall Creek Regional Waste District Sewer System for the above listed property - Permit Type: Residential ☒, Commercial _____, Industrial _____, or Governmental/Institutional _____. User Information _____.

All workmanship and materials shall conform to the standards of the District Ordinance as described in Ordinance 84-2 and 84-3 as amended. Acceptance and approval must be made by the District inspector or his duly authorized representative before backfilling and final connection is made to the main sewer lines. Any violation of applicable regulations will cause all lines and appurtenances in violation to be removed and replaced at the owners expense.

The Fall Creek Regional Waste District is responsible for the inspection, approval of materials, and installation techniques only. All costs for materials and installation and any liabilities resulting from same is the sole responsibility of the property owner.

I have read and fully understand the above provisions and agree to comply by said provisions.

Fred Mac Miller
APPLICANT(S) SIGNATURE

INSPECTOR B


Date inspected 8-17-00 Approved ☒ Rejected _____

Reason for rejection _____

Date reinspected _____ Approved _____ Rejected _____

Notes:
Size Pipe 6 "
Type Pipe PVC
Basement Yes ☒ No _____
Sump Pump Yes ☒ No _____
Downspout to Ground Yes ☒ No _____
Septic Tank Pumped & filled Yes _____ No ☒
Contractor Self
Special Conditions _____

Existing Home _____
New Construction ☒

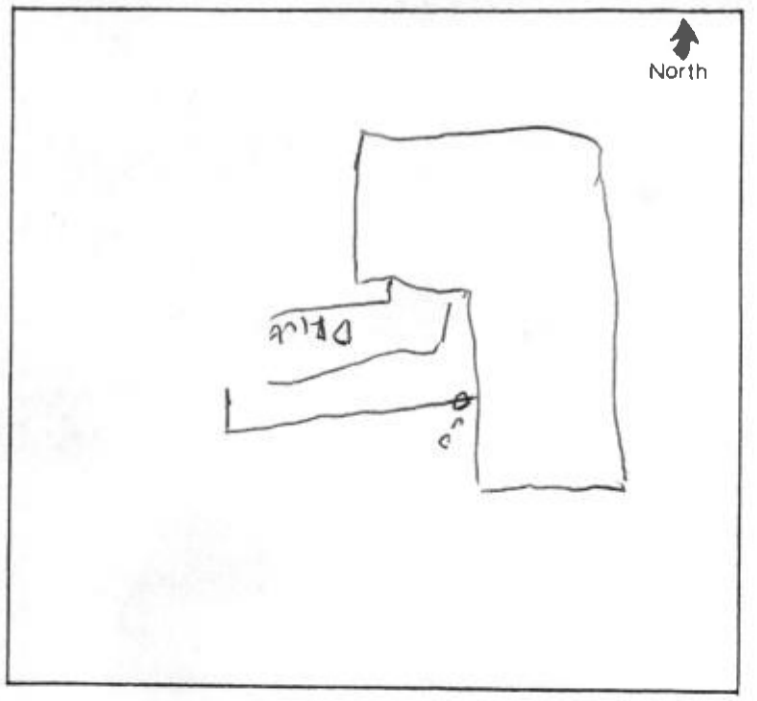

JEFFREY HELPLING
LUCILLE HELPLING

PH. 765-642-9835
128 E 36TH ST.
ANDERSON, IN 46013

71-553/749
400165

1026

DATE June 6, 2000

PAY TO THE ORDER OF FCRWD

\$400.00

Four-hundred and no/100 DOLLARS

Security features included. Details on back.



Madison
Community Bank

MEMO Seven Tap Fee

Jeffrey Helpling

⑆074905539⑆ 400 165 1026

SAFETY PAPER

