

FALL CREEK REGIONAL WASTE DISTRICT

9378 S 650 WEST, P.O. BOX 59, PENDLETON, IN 46064
765-778-7544

№ 5280

26-08260.00

AGREEMENT FOR SANITARY SEWER SERVICE

This Agreement made and entered into this 12th day of July, 2004, between FALL CREEK REGIONAL WASTE DISTRICT ("District") and Ritzy Builders ("Applicant") regarding the provision of sanitary sewer service, and the assignment of capacity in, and connection to, the District's facilities for the premises located at 10727, Foster's Branch Woods

NOW THEREFORE, the parties, in consideration of the mutual promises set out in this Agreement, the receipt and sufficiency of which is hereby acknowledged, agree as follows:

1. The Applicant agrees that all workmanship and materials shall conform to all District ordinances and the District's construction standards. District must accept and approve all work and materials before backfilling and final connection is made to the sewer mains. Any violation of this provision will cause all lines and appurtenances in violation to be removed and replaced at the Applicant's expense.
2. The District shall have the right to enter upon the Applicant's premises at all reasonable times to inspect, repair, or replace any equipment used in connection with the District's service or which has an impact on said service.
3. The Applicant shall be responsible for all monthly user rates, capacity charges, and tap fees. The failure to pay any rate charge or fee may result in a lien against the property and/or the termination of service to the property, the cost of which will be borne by Applicant, including, but not limited to, all attorney's fees and collection costs.
4. The District shall not be responsible for any damages as a result of any failure to supply service unless said damages are due to default, neglect or culpability on the part of the District.
5. If there is an available sanitary sewer within three hundred (300) feet of the property line, the property owner shall be required to connect to the District's sanitary sewer system.
6. The Applicant and District agree that the provision of sanitary sewer service touches and concerns the property and the terms of this Agreement bind the District and Applicant and their heirs, executors, administrators, personal representatives, successors, agents, attorneys, assigns, designees, and transferees.

The parties hereto have read and fully understand the above provisions and agree to comply with said provisions.

FALL CREEK REGIONAL WASTE DISTRICT
Signature Robert Wilson

APPLICANT
Signature Robert Wilson

STATE OF INDIANA)
) SS:
COUNTY OF MADISON)

SUBSCRIBED and sworn to before me this 12th day of July, 2004.

My Commission Expires:
2-20-2008

Signature Deborah L. Wilson
Printed Deborah L. Wilson
Notary Public
Resident of Madison County

INSPECTOR TK DATE INSPECTED 8/13/04 APPROVED ✓ REJECTED _____
REASON FOR REJECTION _____

DATE REINSPECTED _____ APPROVED _____ REJECTED _____

NOTES:
SIZE PIPE 1 1/2" TYPE PIPE 160 PSI

BASEMENT YES NO

SUMP PUMP YES NO

DOWNSPOUT TO GROUND YES NO


SEPTIC TANK PUMPED & FILLED YES NO

CONTRACTOR LOPEZ & HOFFER

SPECIAL CONDITIONS _____

EXISTING HOME _____

NEW CONSTRUCTION ✓

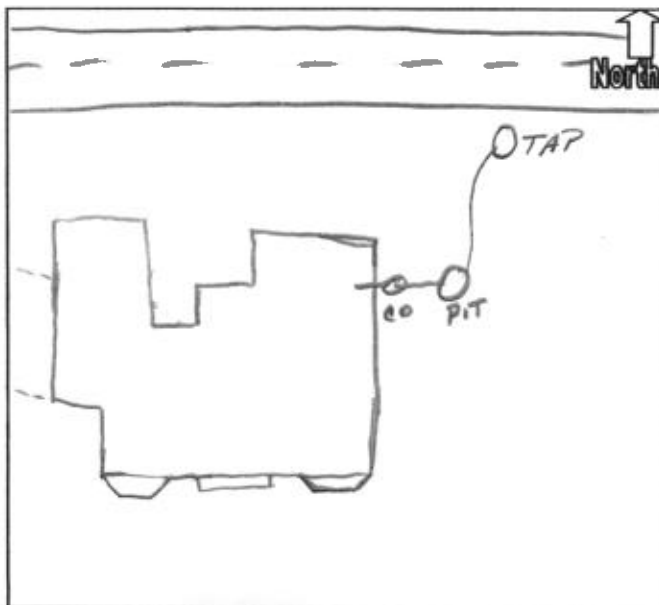

0803

[Faint, mostly illegible text, likely bleed-through from the reverse side of the page. Some words like "The", "and", "of" are visible.]

[Handwritten signature or initials.]

[Handwritten signature or initials.]

[Handwritten text, possibly a date or reference number.]

[Handwritten text, possibly a date or reference number.]

[Large block of faint, illegible text at the bottom of the page, continuing the bleed-through.]

RIFFEY BUILDERS INC.
5205 S. 525W
PENDLETON, IN 46064-9174

71-553/749
7903383

984

DATE 7-12-04

PAY TO THE ORDER OF Fall Creek Waste \$ 4184⁷²

Four Thousand One Hundred Eighty Four⁷²/₁₀₀ DOLLARS



Madison
Community Bank

MEMO David Miller

Robert [Signature]

⑆074905539⑆ 790 338 31⑈ 0984