


Drawing  
+  
3 pictures  
attached









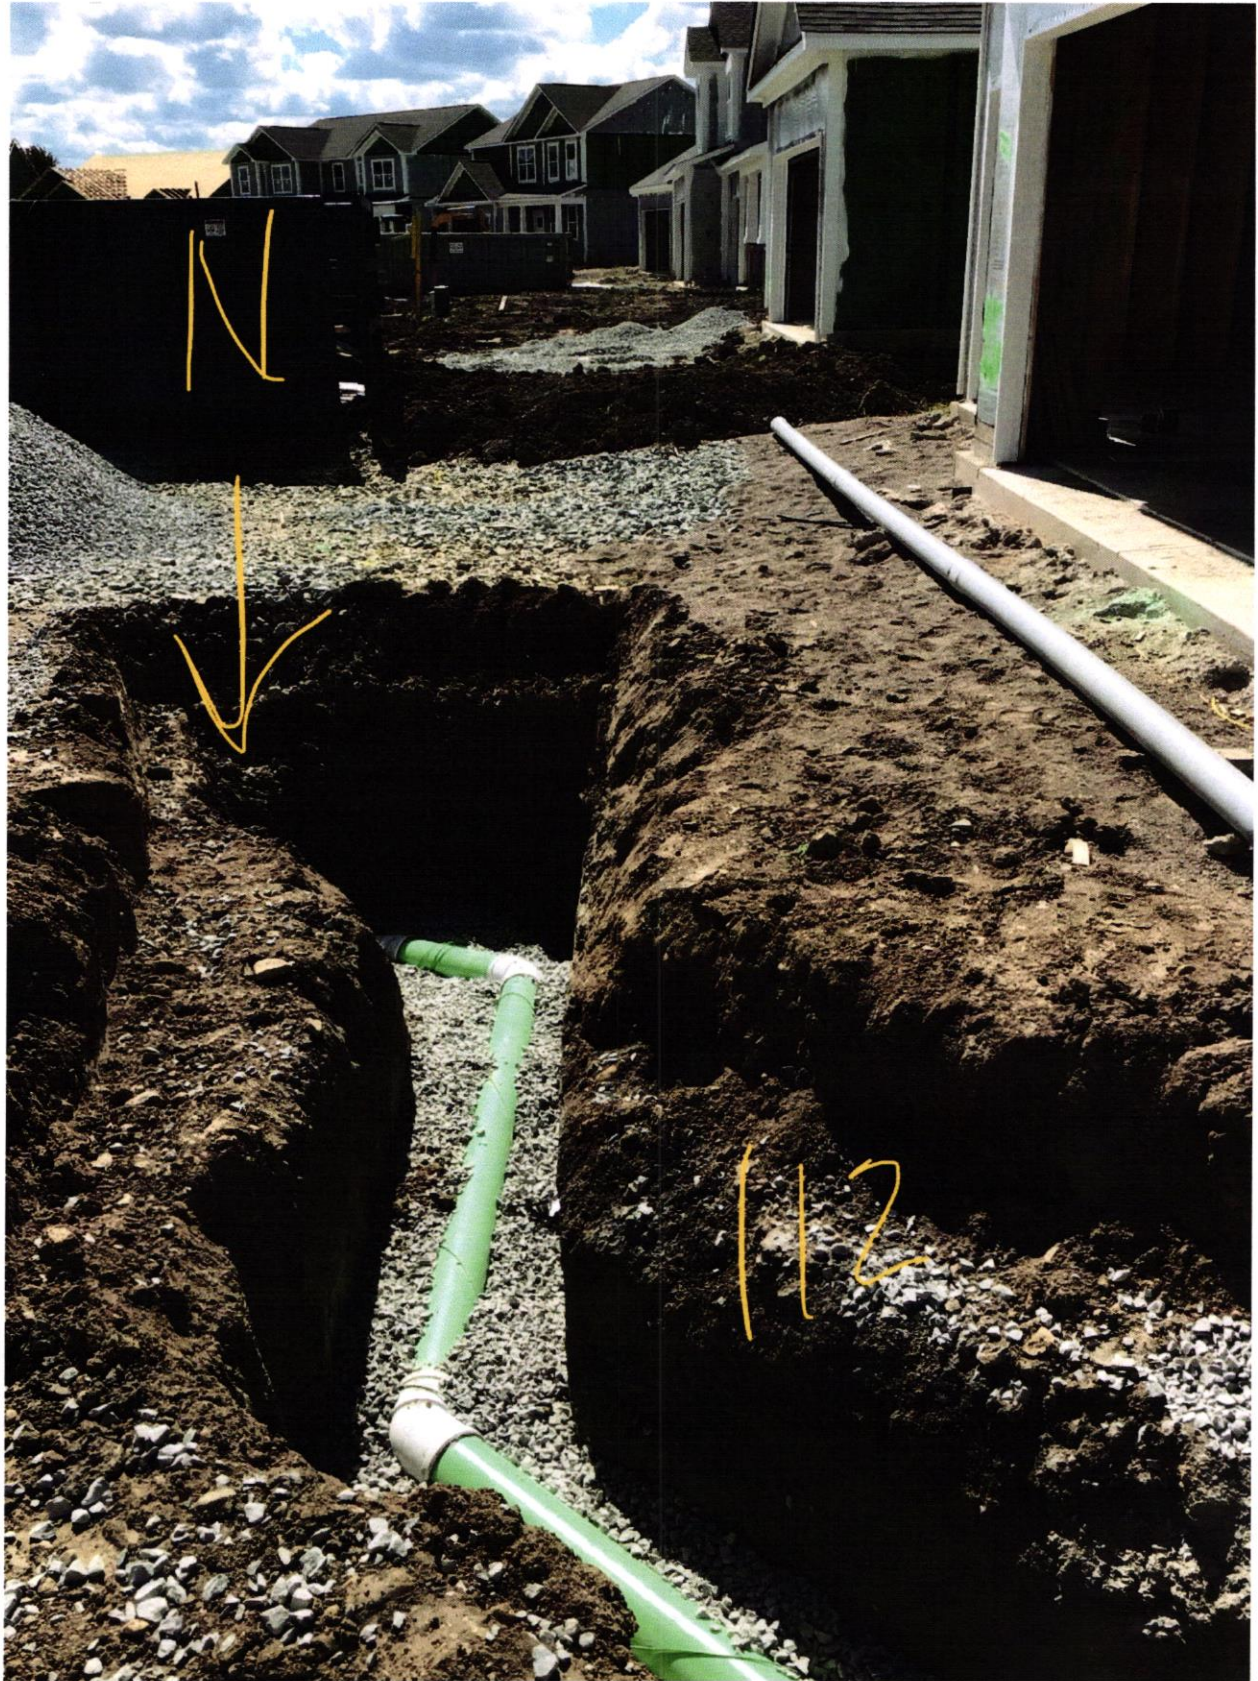





**DR HORTON**  
America's BuilderJP Morgan Chase Bank, N.A.  
Syracuse, NY

Check Number 1449727

**DRH Inc. Controlled Disb**  
1341 Horton Circle  
Arlington, TX 76011

50-937

213

2720128

Date	Amount
02/09/22	\$*****760.00

Void after 6 months from date of issue

**SEVEN HUNDRED SIXTY AND 00/100** \*\*\*\*\*Pay To The Order Of:  
FALL CREEK REGIONAL WASTE DISTRICT  
9378 SOUTH 650 WEST  
PENDLETON IN 46064D. L. Horton

CG 112

012083