


Gidw.

PROJECT Phase II SHEET _____ OF _____
SUBJECT _____ DATE 5-2-18
JOB NO. 4447
BY Atlas

611 S. Broadway

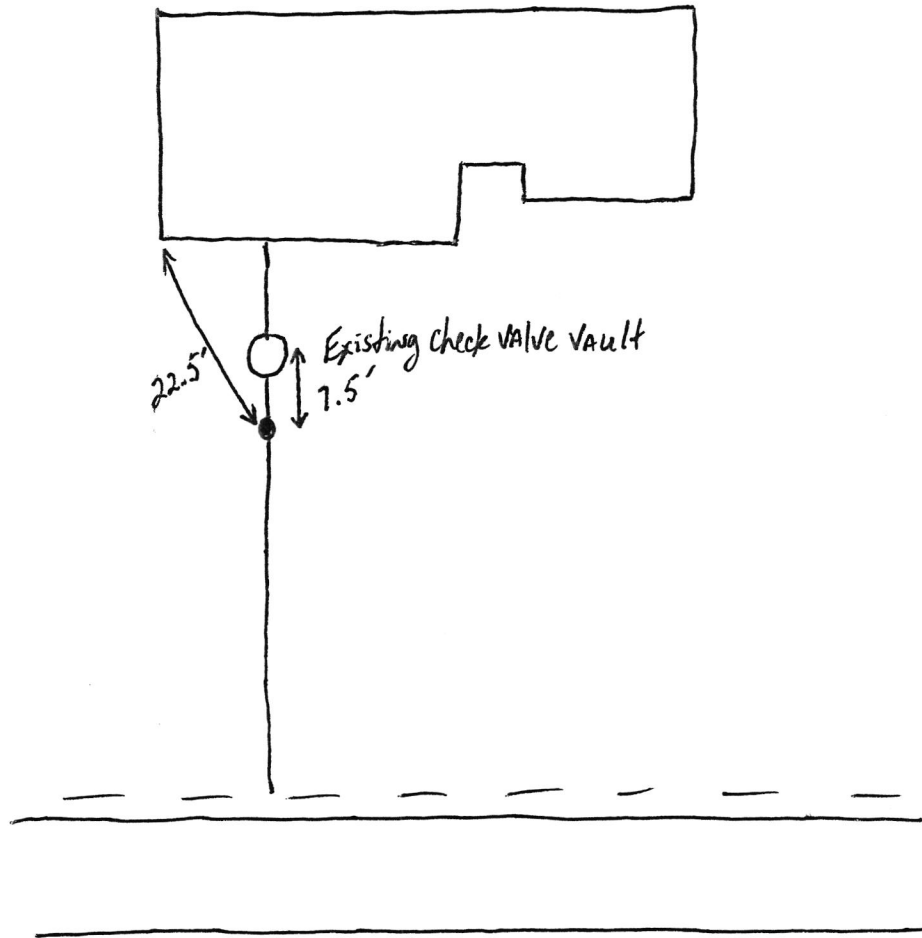

1ell S Broadway

SRF
Phase II

5.3.18

