

22-27070.00 add #der on file



FALL CREEK REGIONAL WASTE DISTRICT

9378 S. 650 West PO Box 59  
Pendleton, IN 46064-0059 778-7544

Transferred from lot #58 to #81

Nº 2523 or 9/22/98

APPLICATION FOR SEWER PERMIT

Date 6/25/98

Permit Void 90 days from Date of Issuance

Owner Name John and Sally Feeney Hallmark Homes

Property Address 6120 S. Fox Court

Lot # 58, HHE #81 P.O. Box \_\_\_\_\_

Town Pendleton, IN Zip Code \_\_\_\_\_

Phone \_\_\_\_\_ City Water \_\_\_\_\_ Well X

\$ 400.00 Tap on Fee Paid

\$ \_\_\_\_\_ Inspection fee paid

Application is hereby made for connection to the Fall Creek Regional Waste District Sewer System for the above listed property - Permit Type: Residential X, Commercial \_\_\_\_\_, Industrial \_\_\_\_\_, or Governmental/Institutional \_\_\_\_\_. User Information \_\_\_\_\_.

All workmanship and materials shall conform to the standards of the District Ordinance as described in Ordinance 84-2 and 84-3 as amended. Acceptance and approval must be made by the District inspector or his duly authorized representative before backfilling and final connection is made to the main sewer lines. Any violation of applicable regulations will cause all lines and appurtenances in violation to be removed and replaced at the owners expense.

The Fall Creek Regional Waste District is responsible for the inspection, approval of materials, and installation techniques only. All costs for materials and installation and any liabilities resulting from same is the sole responsibility of the property owner.

I have read and fully understand the above provisions and agree to comply by said provisions.

Sally Feeney  
APPLICANT(S) SIGNATURE

INSPECTOR Ben

Date inspected 11-30-98 Approved ✓ Rejected \_\_\_\_\_

Reason for rejection \_\_\_\_\_

Date reinspected \_\_\_\_\_ Approved \_\_\_\_\_ Rejected \_\_\_\_\_

Notes:

Size Pipe 6 "

Type Pipe PVC 35

Basement Yes No

Sump Pump Yes No

Downspout to Ground Yes X No


Septic Tank Pumped & filled Yes No X

Contractor GARY RAINEY

Special Conditions \_\_\_\_\_

Existing Home \_\_\_\_\_

New Construction X

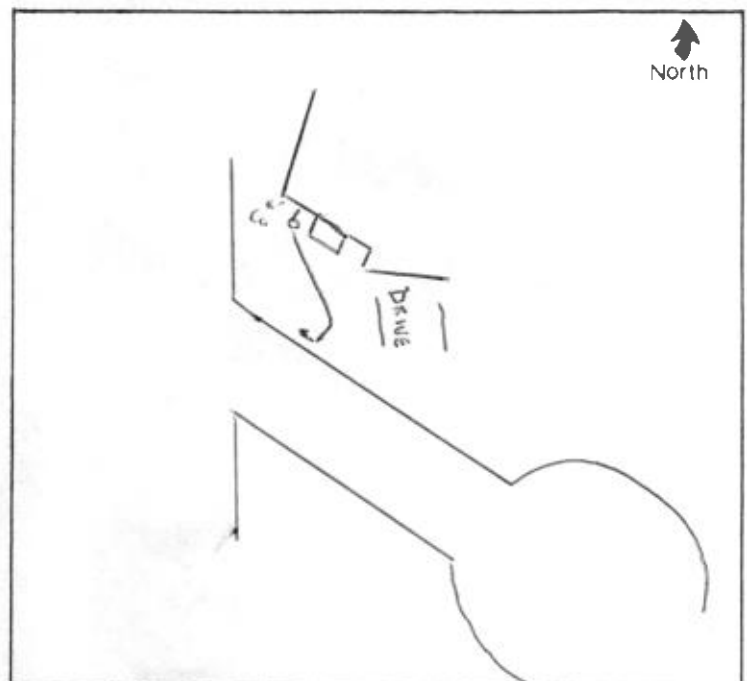



JOHN E. AND SALLY J. FEENEY  
1486 W. MACON  
DECATUR, IL. 62522  
(217)429-1090

6/25 19 98 2512

70-8301/2711

PAY TO THE  
ORDER OF

FCRWD

\$ 400.00

Four hundred

00/100 DOLLARS

SECURITY  
FEATURES INCLUDED.  
DETAILS ON BACK.



LAND OF LINCOLN  
CREDIT UNION

DECATUR, ILLINOIS 62525 217/428-4438

MEMO

Sewer permit

Sally J. Feeny

MP

⑆271183015⑆00000018790603⑈2512

