

Gidw.

PROJECT Phase II SHEET _____ OF _____

SUBJECT _____ DATE 5-7-18


JOB NO 4447

BY Atlas

612 S. BROADWAY

620 & 612 in the
same trench

620

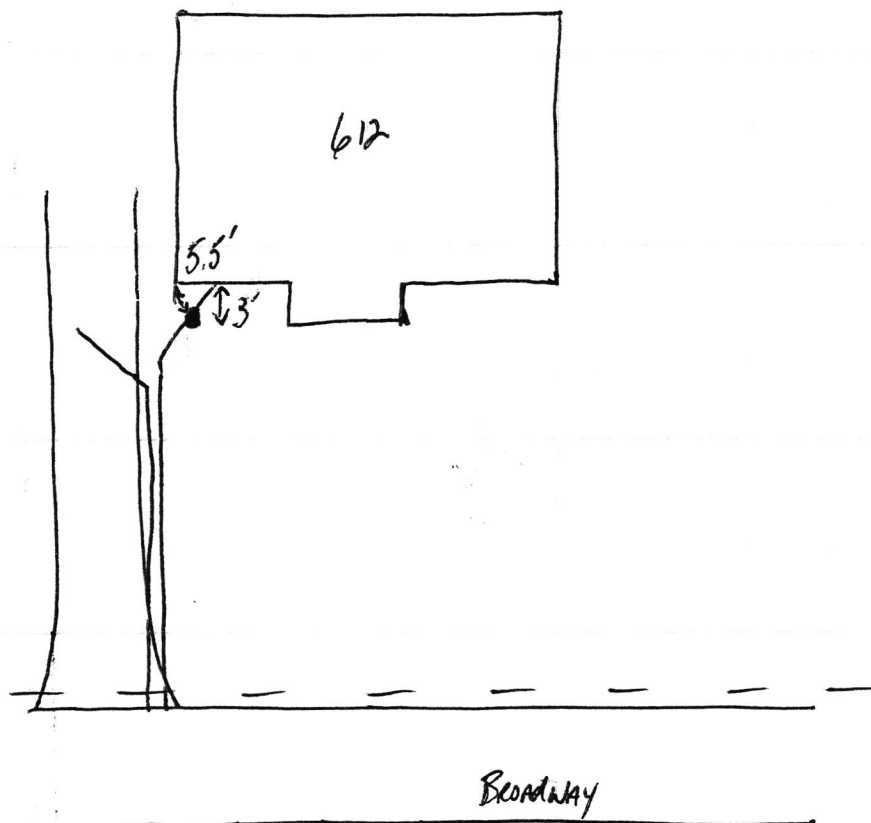

Lola S Broadway

SRF Phase II

5.14.18

