



FALL CREEK REGIONAL WASTE DISTRICT

9378 S. 650 West PO Box 59
Pendleton, IN 46064-0059 778-7544

add order
on file

26-08250.00

APPLICATION FOR SEWER PERMIT

Nº 2757

Date 4-19-00

Permit Void 90 days from Date of Issuance

Owner Name Riffey Builders

Property Address 6131 N. Foster Branch. Fosters Branch Woods

Lot # 26

P.O. Box Drive

Town Pendleton

IN Zip code 46064

Phone _____

City Water _____

Well ☒

\$ 2556.00 Tap on Fee Paid

Grander Unit pd for by
Long & Koffer 1024.80

\$ _____ Inspection fee paid

Application is hereby made for connection to the Fall Creek Regional Waste District Sewer System for the above listed property - Permit Type: Residential ☒, Commercial _____, Industrial _____, or Governmental/Institutional _____. User Information _____.

All workmanship and materials shall conform to the standards of the District Ordinance as described in Ordinance 84-2 and 84-3 as amended. Acceptance and approval must be made by the District inspector or his duly authorized representative before backfilling and final connection is made to the main sewer lines. Any violation of applicable regulations will cause all lines and appurtenances in violation to be removed and replaced at the owners expense.

The Fall Creek Regional Waste District is responsible for the inspection, approval of materials, and installation techniques only. All costs for materials and installation and any liabilities resulting from same is the sole responsibility of the property owner.

I have read and fully understand the above provisions and agree to comply by said provisions.

Harold E Riffey
APPLICANT(S) SIGNATURE

INSPECTOR Tim

Date inspected 5-18-00

Approved ☒

Rejected _____

Reason for rejection _____

Date reinspected _____

Approved _____

Rejected _____

Notes:

Size Pipe 4"

Type Pipe SDR35

Basement Yes _____ No ☒

Sump Pump Yes _____ No ☒

Downspout to Ground Yes ☒ No _____


Septic Tank Pumped & filled Yes _____ No _____

Contractor Long & Koffer

Special Conditions _____

Existing Home _____

New Construction ☒

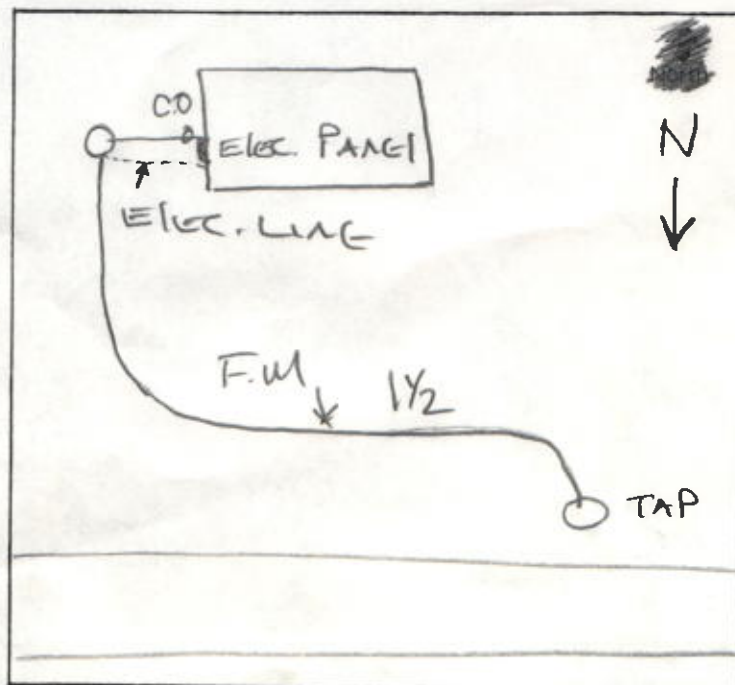

LONG & KOFFER, INC.
1795 W. HUNTSVILLE RD.
PENDLETON, INDIANA 46064
765/778-5219

NATIONAL CITY BANK
INDIANAPOLIS, INDIANA 46255
20-6/740

PAY TO THE
ORDER OF

Fall Creek Regional Waste District

\$ 1024.80

One Thousand Twenty-four Dollars and

80/100 DOLLARS

MEMO:

John A. Boffa

⑈001113⑈ ⑆074000065⑆ 501977276⑈

SECURITY FEATURES: MICRO PRINT TOP & BOTTOM BORDERS - COLORED PATTERN - ARTIFICIAL WATERMARK ON REVERSE SIDE - MISSING FEATURE INDICATES A COPY