

FALL CREEK REGIONAL WASTE DISTRICT

9378 S 650 WEST, P.O. BOX 59, PENDLETON, IN 46064

765-778-7544

AGREEMENT FOR SANITARY SEWER SERVICE

This Agreement made and entered into this 21st day of October, 2003, between FALL CREEK REGIONAL WASTE DISTRICT ("District") and Troy McKinley ("Applicant") regarding the provision of sanitary sewer service, and the assignment of capacity in, and connection to, the District's facilities for the premises located at 101129, Hickory Hills East

NOW THEREFORE, the parties, in consideration of the mutual promises set out in this Agreement, the receipt and sufficiency of which is hereby acknowledged, agree as follows:

1. The Applicant agrees that all workmanship and materials shall conform to all District ordinances and the District's construction standards. District must accept and approve all work and materials before backfilling and final connection is made to the sewer mains. Any violation of this provision will cause all lines and appurtenances in violation to be removed and replaced at the Applicant's expense.
2. The District shall have the right to enter upon the Applicant's premises at all reasonable times to inspect, repair, or replace any equipment used in connection with the District's service or which has an impact on said service.
3. The Applicant shall be responsible for all monthly user rates, capacity charges, and tap fees. The failure to pay any rate charge or fee may result in a lien against the property and/or the termination of service to the property, the cost of which will be borne by Applicant, including, but not limited to, all attorney's fees and collection costs.
4. The District shall not be responsible for any damages as a result of any failure to supply service unless said damages are due to default, neglect or culpability on the part of the District.
5. If there is an available sanitary sewer within three hundred (300) feet of the property line, the property owner shall be required to connect to the District's sanitary sewer system.
6. The Applicant and District agree that the provision of sanitary sewer service touches and concerns the property and the terms of this Agreement bind the District and Applicant and their heirs, executors, administrators, personal representatives, successors, agents, attorneys, assigns, designees, and transferees.

The parties hereto have read and fully understand the above provisions and agree to comply with said provisions.

FALL CREEK REGIONAL WASTE DISTRICT
Heather Wilson
 Signature

APPLICANT: E. M. McKelvey
Signature

STATE OF INDIANA)
) SS:
COUNTY OF MADISON)

SUBSCRIBED and sworn to before me this 22nd day of October, 200 3

My Commission Expires: 2-20-2008

Signature Deborah J. Wilson

Printed Deborah L. Wilson

Notary Public
Resident of Madison County

INSPECTOR	DATE INSPECTED	APPROVED	REJECTED
-----------	----------------	----------	----------

REASON FOR REJECTION

DATE REINSPECTED	APPROVED	REJECTED
------------------	----------	----------

NOTES:
SIZE PIPE TYPE PIPE

BASEMENT YES NO

SUMP PUMP YES NO

DOWNSPOUT TO GROUND YES NO


SEPTIC TANK PUMPED & FILLED YES NO

 
CONTRACTOR

SPECIAL CONDITIONS

EXISTING HOME

NEW CONSTRUCTION

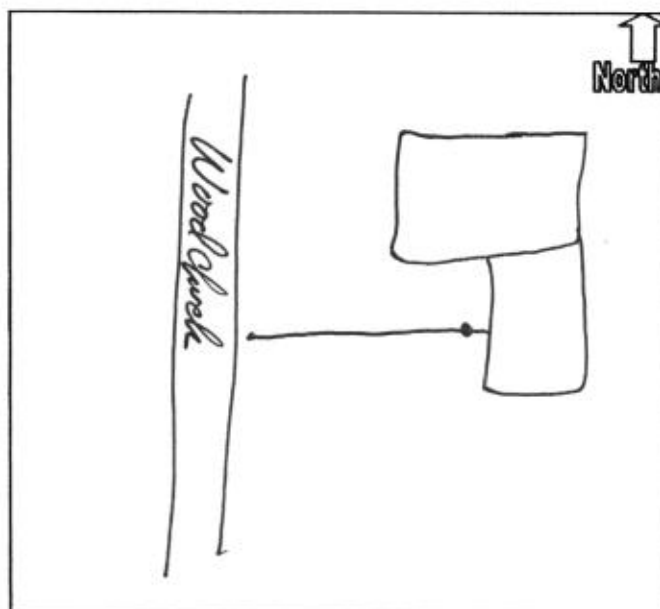



FALL CREEK REGIONAL WASTE DISTRICT

No 5005

9378 S 650 WEST, P.O. BOX 59, PENDLETON, IN 46064

765-778-7544

AGREEMENT FOR SANITARY SEWER SERVICE

This Agreement made and entered into this 22nd day of October, 2003, between FALL CREEK REGIONAL WASTE DISTRICT ("District") and Troy McKinley ("Applicant") regarding the provision of sanitary sewer service, and the assignment of capacity in, and connection to, the District's facilities for the premises located at 107129, Hickory Hills East

NOW THEREFORE, the parties, in consideration of the mutual promises set out in this Agreement, the receipt and sufficiency of which is hereby acknowledged, agree as follows:

1. The Applicant agrees that all workmanship and materials shall conform to all District ordinances and the District's construction standards. District must accept and approve all work and materials before backfilling and final connection is made to the sewer mains. Any violation of this provision will cause all lines and appurtenances in violation to be removed and replaced at the Applicant's expense.
2. The District shall have the right to enter upon the Applicant's premises at all reasonable times to inspect, repair, or replace any equipment used in connection with the District's service or which has an impact on said service.
3. The Applicant shall be responsible for all monthly user rates, capacity charges, and tap fees. The failure to pay any rate charge or fee may result in a lien against the property and/or the termination of service to the property, the cost of which will be borne by Applicant, including, but not limited to, all attorney's fees and collection costs.
4. The District shall not be responsible for any damages as a result of any failure to supply service unless said damages are due to default, neglect or culpability on the part of the District.
5. If there is an available sanitary sewer within three hundred (300) feet of the property line, the property owner shall be required to connect to the District's sanitary sewer system.
6. The Applicant and District agree that the provision of sanitary sewer service touches and concerns the property and the terms of this Agreement bind the District and Applicant and their heirs, executors, administrators, personal representatives, successors, agents, attorneys, assigns, designees, and transferees.

The parties hereto have read and fully understand the above provisions and agree to comply with said provisions.

FALL CREEK REGIONAL WASTE DISTRICT
Debra Wilson
Signature

APPLICANT
Troy McKinley
Signature

STATE OF INDIANA)
) SS:
COUNTY OF MADISON)

SUBSCRIBED and sworn to before me this 22nd day of October, 2003.

My Commission Expires:
2-20-2008

Signature Deborah L. Wilson

Printed Deborah L. Wilson

Notary Public
Resident of Madison County

INSPECTOR _____ DATE INSPECTED _____ APPROVED _____ REJECTED _____

REASON FOR REJECTION _____

DATE REINSPECTED _____ APPROVED _____ REJECTED _____

NOTES:
SIZE PIPE _____ TYPE PIPE _____

BASEMENT YES _____ NO _____

SUMP PUMP YES _____ NO _____

DOWNSPOUT TO GROUND YES _____ NO _____


SEPTIC TANK PUMPED & FILLED YES _____ NO _____

CONTRACTOR _____

SPECIAL CONDITIONS _____

EXISTING HOME _____

NEW CONSTRUCTION _____

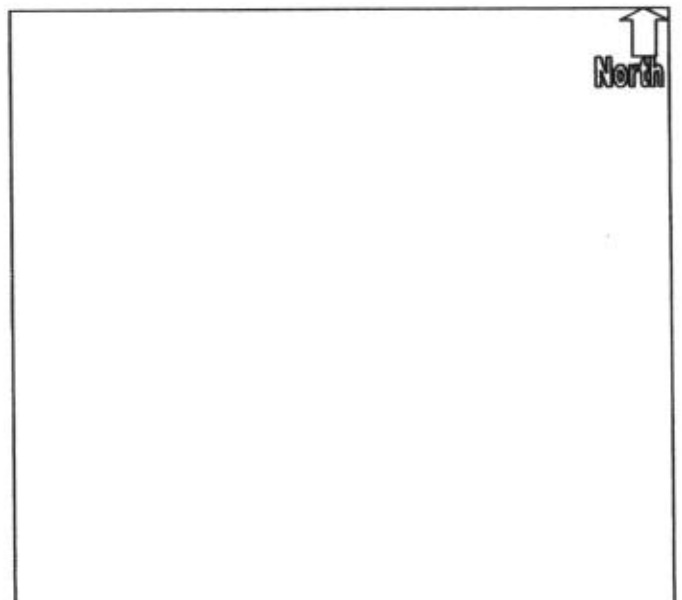

TROY M. MCKINLEY 08-93
LESLI A. MCKINLEY
508 ERNIE LU
ANDERSON, IN 46013

20-7043/2740
175012729

1037

10/22/03
DATE

© DELUXE WALLET OR DUPLICATE ©

FORWARD \$ 475.00
AT THE ORDER OF
Five hundred Seventy five dollars and 00/100 — DOLLARS

Security Features
Included.
Details on Back.

 **FIRST INDIANA BANK**
INDIANAPOLIS, INDIANA 46204

20110

Lesli A. McKinley

MP

⑆274070439⑆ 175012729⑈ 1037

SCENIC AMERICANA