

FALL CREEK REGIONAL WASTE DISTRICT

No 5517

9378 S 650 WEST, P.O. BOX 59, PENDLETON, IN 46064
765-778-7544

22-27535.00

AGREEMENT FOR SANITARY SEWER SERVICE

This Agreement made and entered into this 8th day of April, 2005, between FALL CREEK REGIONAL WASTE DISTRICT ("District") and Brad Tyler ("Applicant") regarding the provision of sanitary sewer service, and the assignment of capacity in, and connection to, the District's facilities for the premises located at HHE 107 113 6167 S Lemming Ct.

NOW THEREFORE, the parties, in consideration of the mutual promises set out in this Agreement, the receipt and sufficiency of which is hereby acknowledged, agree as follows:

- 1. The Applicant agrees that all workmanship and materials shall conform to all District ordinances and the District's construction standards. District must accept and approve all work and materials before backfilling and final connection is made to the sewer mains. Any violation of this provision will cause all lines and appurtenances in violation to be removed and replaced at the Applicant's expense.
- 2. The District shall have the right to enter upon the Applicant's premises at all reasonable times to inspect, repair, or replace any equipment used in connection with the District's service or which has an impact on said service.
- 3. The Applicant shall be responsible for all monthly user rates, capacity charges, and tap fees. The failure to pay any rate charge or fee may result in a lien against the property and/or the termination of service to the property, the cost of which will be borne by Applicant, including, but not limited to, all attorney's fees and collection costs.
- 4. The District shall not be responsible for any damages as a result of any failure to supply service unless said damages are due to default, neglect or culpability on the part of the District.
- 5. If there is an available sanitary sewer within three hundred (300) feet of the property line, the property owner shall be required to connect to the District's sanitary sewer system.
- 6. The Applicant and District agree that the provision of sanitary sewer service touches and concerns the property and the terms of this Agreement bind the District and Applicant and their heirs, executors, administrators, personal representatives, successors, agents, attorneys, assigns, designees, and transferees.

The parties hereto have read and fully understand the above provisions and agree to comply with said provisions.

FALL CREEK REGIONAL WASTE DISTRICT
Norah Wilson
Signature

APPLICANT
Anda Tyler
Signature

STATE OF INDIANA)
) SS:
COUNTY OF MADISON)

SUBSCRIBED and sworn to before me this 8th day of April, 2005.

My Commission Expires: 2-20-2008

Signature Deborah L. Wilson
Printed Deborah L. Wilson


Notary Public
Resident of Madison County

INSPECTOR JT DATE INSPECTED 8-18-05 APPROVED X REJECTED _____

REASON FOR REJECTION _____

DATE REINSPECTED _____ APPROVED _____ REJECTED _____

NOTES:
 SIZE PIPE 6" TYPE PIPE SOR35
 BASEMENT YES X NO _____
 SUMP PUMP YES _____ NO X
 DOWNSPOUT TO GROUND YES _____ NO _____
 SEPTIC TANK PUMPED & FILLED YES _____ NO _____
 CONTRACTOR B.L. Brown
 SPECIAL CONDITIONS _____
 EXISTING HOME _____
 NEW CONSTRUCTION X

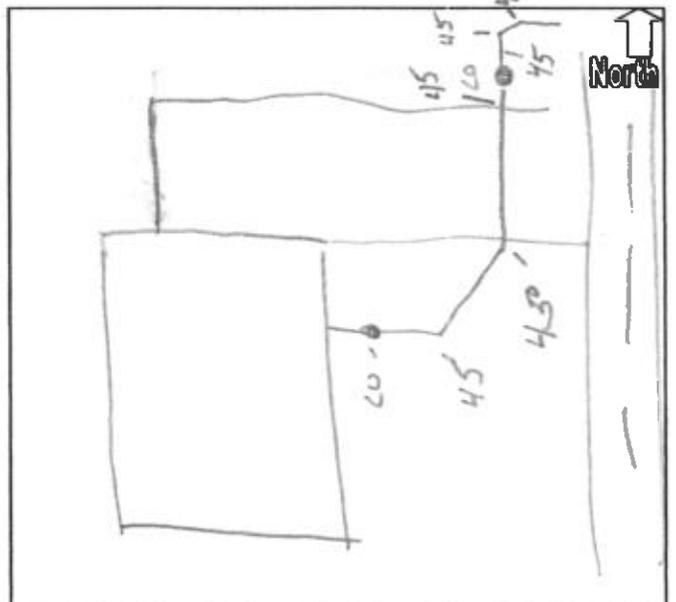

Bradley Tyler
Linda Tyler
6150 S Fox Court
Pendleton, IN 46064
PH. 765-778-4214

5246

DATE 4-8-05

20-6/0740

PAY
TO THE
ORDER OF

FC RWD

\$ 475

Four hundred seventy five

DOLLARS

NATIONAL CITY BANK
INDIANAPOLIS, INDIANA 46255

FOR Lot 113

Linda Tyler

⑆074000065⑆ 501251992⑈

5246

Classic Safety