22-27076.00

add order on file




FALL CREEK REGIONAL WASTE DISTRICT 9378 S. 650 West PO Box 59

Pendleton, IN 46064-0059 778-7544

builder: Mark Stout

APPLICATION FOR SEWER PERMIT Nº 2516
Date 6/5/98
Permit Void 90 days from Date of Issuance
Owner Name David & Lee Nix
Property Address 6177 5 Fox Court
Lot # 85, HHE P.O. Box
Town Pendleton, IN zip Code
Phone City Water Well
\$ 400.00 Tap on Fee Paid
\$Inspection fee paid
Application is hereby made for connection to the Fall Creek Regional Waste District Sewer System for the above listed property - Permit Type: Residential, Commercial, Industrial, or Governmental/ Institutional
All workmanship and materials shall conform to the standards of the District Ordinance as described in Ordinance 84-2 and 84-3 as amended. Acceptance and approval must be made by the District inspector or his duly authorized representative before backfilling and final connection is made to the main sewer lines. Any violation of applicable regulations will cause all lines and appurtenances in violation to be removed and replaced at the owners expense.
The Fall Creek Regional Waste District is responsible for the inspection, approval of materials, and installation techniques only. All costs for materials and installation and any liabilities resulting from same is the sole responsibility of the property owner.
I have read and fully understand the above provisions and agree to comply by said provisions.
Applicant(s) SIGNATURE
APPLICANT(S) SIGNATURE
Date inspected 11-2098 Approved A Rejected
Reason for rejection Rejected
reason for telection
Date reinspected Approved Rejected
Rotes:
Size Pipe 6
Type Pipe PUC
Basement Yes No X

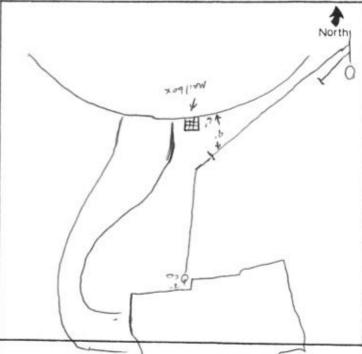

Sump Pump Yes No X

Special Conditions

Existing Home

Downspout to Ground Yes / No

Contractor Hellier Excav.

New Construction X

Septic Tank Pumped & filled Yes