

FALL CREEK REGIONAL WASTE DISTRICT

No 6177

9578 S 650 WEST, P.O. BOX 59, PENDLETON, IN 46064

765-778-7544

AGREEMENT FOR SANITARY SEWER SERVICE

26-10015.00

This Agreement made and entered into this 21st day of February, 2007, between FALL CREEK REGIONAL WASTE DISTRICT ("District") and Maciej Redziora ("Applicant") regarding the provision of sanitary sewer service, and the assignment of capacity in, and connection to, the District's facilities for the premises located at 6179 S Fox Chase Lot 31.

NOW THEREFORE, the parties, in consideration of the mutual promises set out in this Agreement, the receipt and sufficiency of which is hereby acknowledged, agree as follows:

1. The Applicant agrees that all workmanship and materials shall conform to all District ordinances and the District's construction standards. District must accept and approve all work and materials before backfilling and final connection is made to the sewer mains. Any violation of this provision will cause all lines and appurtenances in violation to be removed and replaced at the Applicant's expense.
2. The District shall have the right to enter upon the Applicant's premises at all reasonable times to inspect, repair, or replace any equipment used in connection with the District's service or which has an impact on said service.
3. The Applicant shall be responsible for all monthly user rates, capacity charges, and tap fees. The failure to pay any rate charge or fee may result in a lien against the property and/or the termination of service to the property, the cost of which will be borne by Applicant, including, but not limited to, all attorney's fees and collection costs.
4. The District shall not be responsible for any damages as a result of any failure to supply service unless said damages are due to default, neglect or culpability on the part of the District.
5. If there is an available sanitary sewer within three hundred (300) feet of the property line, the property owner shall be required to connect to the District's sanitary sewer system.
6. The Applicant and District agree that the provision of sanitary sewer service touches and concerns the property and the terms of this Agreement bind the District and Applicant and their heirs, executors, administrators, personal representatives, successors, agents, attorneys, assigns, designees, and transferees.

The parties hereto have read and fully understand the above provisions and agree to comply with said provisions.

FALL CREEK REGIONAL WASTE DISTRICT
Signature Deborah L. Wilson

APPLICANT
Signature Maciej Redziora

STATE OF INDIANA)
) SS:
COUNTY OF MADISON)

SUBSCRIBED and sworn to before me this 21st day of February, 2007.


My Commission Expires: 2-20-2008

Signature Deborah L. Wilson
Printed Deborah L. Wilson
Notary Public
Resident of Madison County

INSPECTOR TIM DATE INSPECTED 3-26-07 APPROVED _____ REJECTED _____
REASON FOR REJECTION _____

DATE REINSPECTED _____ APPROVED _____ REJECTED _____

NOTES:
SIZE PIPE 4" TYPE PIPE SOR 35
BASEMENT YES / NO
SUMP PUMP YES / NO
DOWNSPOUT TO GROUND YES / NO
SEPTIC TANK PUMPED & FILLED YES / NO
CONTRACTOR TOM DAVIS
SPECIAL CONDITIONS _____
EXISTING HOME YES
NEW CONSTRUCTION _____

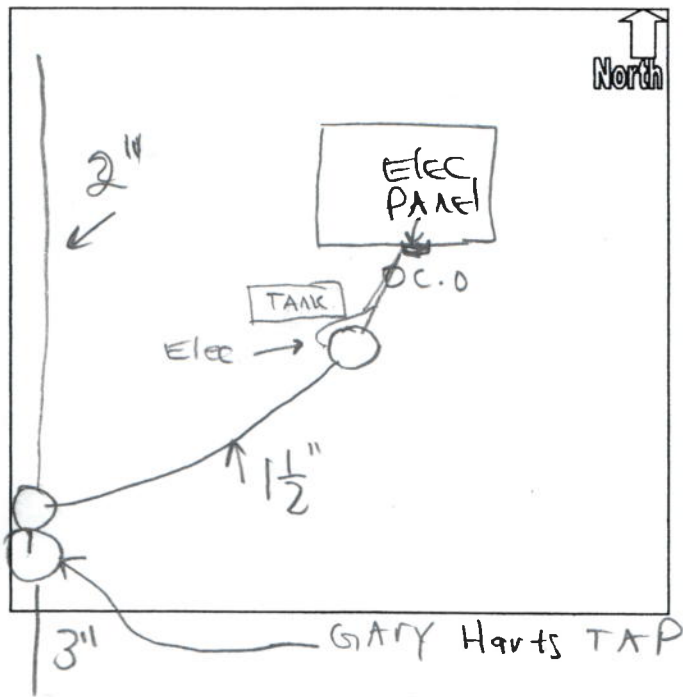



LIDIA B. AND MACIEJ KEDZIORA
6179 S. FOX CHASE DR.
PENDLETON, IN 46064

71-167-749

2169

02/21 20 07

PAY TO THE
ORDER OF

Fall Creek Regional Waste District \$ 1378.00

One thousand three hundred seventy eight dollars DOLLARS



Security Features
Included
Details on Back.

STAR FINANCIAL BANK
"HOOSIER OWNED & HOOSIER PROUD"

FOR Waste water grinder unit

M. Kedziora

MP

⑆074901672⑆ 2169⑈122 53641⑈

© BARBARA W. WILSON



LIDIA B. AND MACIEJ KEDZIORA
6179 S. FOX CHASE DR.
PENDLETON, IN 46064

71-167-749

2170

02/21 20 07

PAY TO THE ORDER OF Fall Creele Regional Waste District \$ 475.00
Four hundred seventy five dollars and DOLLARS



STAR FINANCIAL BANK
"HOOSIER OWNED & HOOSIER PROUD"

FOR

Tap-on fee

M. Kedziora

MP

⑆074901672⑆ 2170⑈122 53641⑈

06-0108-1-031