

Gidw.


PROJECT Phase II SHEET _____ OF _____

SUBJECT _____ DATE 6-9-18

JOB NO. 4447

BY Atlas

617 S. Center

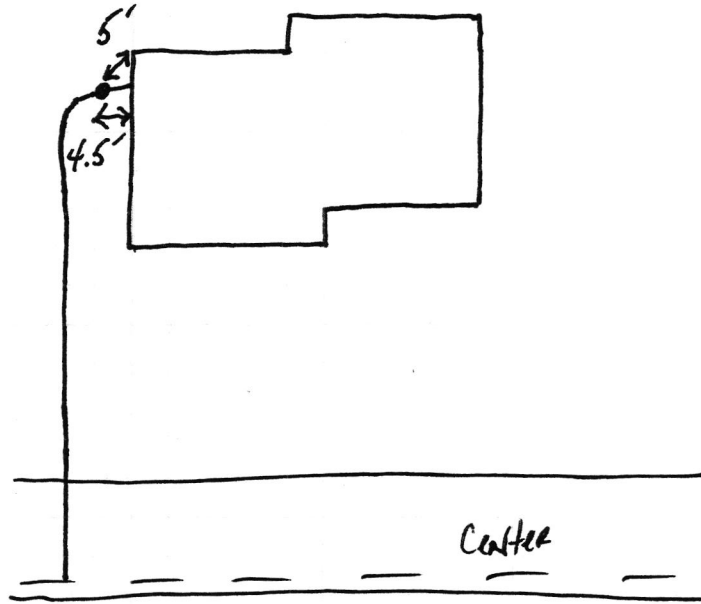

W7 S Center

SRC Phase II

6.11.18

