



FALL CREEK REGIONAL WASTE DISTRICT

Box 44, Pendleton, Indiana 46064

J+A

Nbw

2-0007020

Nº 000595

APPLICATION FOR SEWER PERMIT

Permit No. \_\_\_\_\_ Date 11-14-85  
Permit Void 90 days from Date of Issuance  
Owner Name DOUG BARRETT  
Property Address 617 1MY LANE  
Lot # \_\_\_\_\_ P.O. Box \_\_\_\_\_  
Town ANDERSON, IN Zip Code 46013  
Phone 643-8804 Water Meter \_\_\_\_\_  
\$ 150.00 Tap on Fee Paid  
\$ 25.00 Inspection fee paid

Application is hereby made for connection to the Fall Creek Regional Waste District Sewer System for the above listed property - Permit Type: Residential X, Commercial \_\_\_\_\_, Industrial \_\_\_\_\_, or Governmental/Institutional \_\_\_\_\_. User Information \_\_\_\_\_.

All workmanship and materials shall conform to the standards of the District Ordinance as described in Ordinance 84-2 and 84-3 as amended. Acceptance and approval must be made by the District inspector or his duly authorized representative before backfilling and final connection is made to the main sewer lines. Any violation of applicable regulations will cause all lines and appurtenances in violation to be removed and replaced at the owners expense.

The Fall Creek Regional Waste District is responsible for the inspection, approval of materials, and installation techniques only. All costs for materials and installation and any liabilities resulting from same is the sole responsibility of the property owner.

I have read and fully understand the above provisions and agree to comply by said provisions.

Kathy A. Barrett  
APPLICANT(S) SIGNATURE

\*\*\*\*\*

INSPECTOR Katy

Date inspected 1/14/86 Approved ✓ Rejected \_\_\_\_\_

Reason for rejection \_\_\_\_\_

Date reinspected \_\_\_\_\_ Approved \_\_\_\_\_ Rejected \_\_\_\_\_

Notes:

Size Pipe 6 "

Type Pipe PVC

Basement Yes \_\_\_\_\_ No ✓


Sump Pump Yes \_\_\_\_\_ No ✓

Downspout to Ground Yes \_\_\_\_\_ No ✓

Septic Tank Pumped & filled Yes \_\_\_\_\_ No ✓

Contractor TERRY COX

Special Conditions \_\_\_\_\_

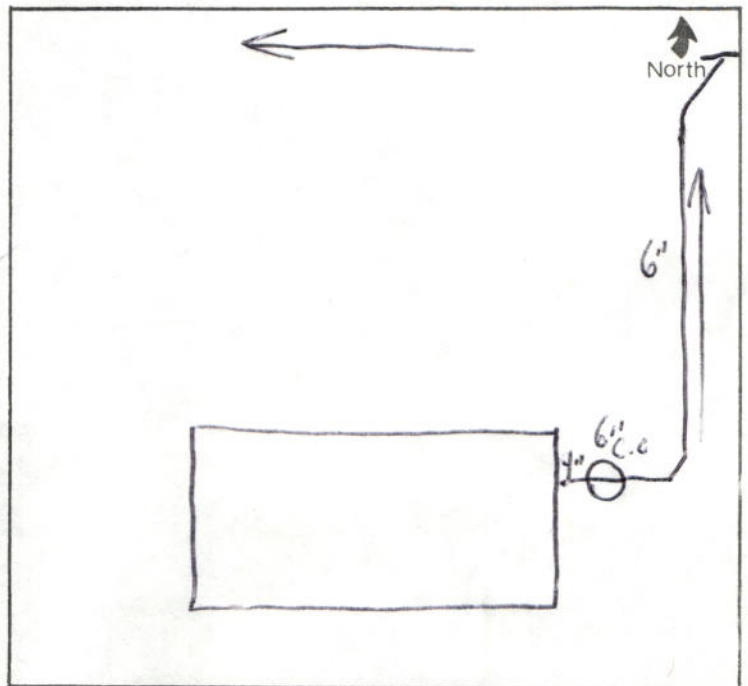

60



NA000202

11-14-82

Doug BARTETT  
617 MY LANE

40013


120.00  
25.00  
643-8804  
ANDERSON

X

Handwritten signature or name.

Handwritten initials or mark.

Handwritten initials or mark.

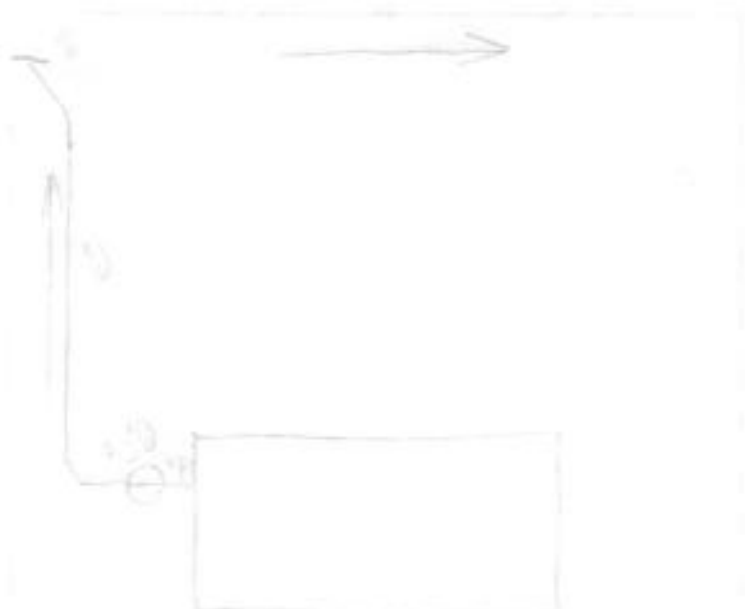

Handwritten text.

Handwritten text.