

26- 68390.00

Fall Creek Regional Waste District  
9378 S 650 W, P.O. Box 59, Pendleton, IN 46064  
765-778-7544

#6485

Agreement for Sanitary Sewer Service

This Agreement made and entered into this 15 day of April, 2014, between Fall Creek Regional Waste District ("District") and Jeff Roberts General ("Applicant") regarding the provision of sanitary sewer service, and the assignment of capacity in and connection to, the District's facilities for the premises located at Foster Branch Ridge Lot 10.

6188 Foster Branch Ridge Lane

Now therefore, the parties, in consideration of the mutual promises set out in this Agreement, the receipt and sufficiency of which is hereby acknowledged, agree as follows:

1. The Applicant agrees that all workmanship and materials shall conform to all District ordinances and the District's construction standards. District must accept and approve all work and materials before backfilling and final connection is made to the sewer mains. Any violation of this provision will cause all lines and appurtenances in violation to be removed and replaced at the Applicant's expense.
2. The District shall have the right to enter upon the Applicant's premises at all reasonable times to inspect, repair, or replace any equipment used in connection with the District's service or which has an impact on said service.
3. The Applicant shall be responsible for all monthly user rates, capacity charges, and tap fees. The failure to pay any rate charge or fee may result in a lien against the property and/or the termination of service to the property, the cost of which will be borne by Applicant, including, but not limited to, all attorney's fees and collection costs.
4. The District shall not be responsible for any damages as a result of any failure to supply service unless said damages are due to default, neglect or culpability on the part of the District.
5. If there is an available sanitary sewer within three hundred (300) feet of the property line, the property owner shall be required to connect to the District's sanitary sewer system.
6. The Applicant and District agree that the provision of sanitary sewer service touches and concerns the property and the terms of this Agreement bind the District and Applicant and their heirs, executors, administrators, personal representatives, successors, agents, attorneys, assigns, designees, and transferees.

The parties hereto have read and fully understand the above provisions and agree to comply with said provisions.

FALL CREEK REGIONAL WASTE DISTRICT

Rebecca Lynn Hunter  
Signature

APPLICANT  
Jeff Roberts Pres  
Signature

STATE OF INDIANA )  
 ) SS:  
COUNTY OF MADISON )

SUBSCRIBED and sworn to before me this 15 day of April, 2014

My Commission Expires:  
Commission Expires November 20, 2015  
A Resident of  
Hamilton County, Indiana  
Rebecca Lynn Hunter, Notary Public




Signature Rebecca Lynn Hunter  
Printed Rebecca Lynn Hunter  
Notary Public  
Resident of Hamilton County

\*\*\*\*\*

Inspector Don Date Inspected 7-15-14 Approved ☒ Rejected ☐  
Reason for Rejection \_\_\_\_\_

Date Reinspected \_\_\_\_\_ Approved \_\_\_\_\_ Rejected \_\_\_\_\_

Notes:  
Size Pipe 4" Type Pipe DVC  
Basement Yes ☐ No ☒  
Sump Pump Yes ☐ No ☒  
Downspout to Ground Yes ☒ No ☐  
Septic Tank Pumped & Filled Yes ☒ No ☐  
Contractor JAY WEATHERLY ETC.  
Special Conditions \_\_\_\_\_  
Existing Home ☐  
New Construction ☒

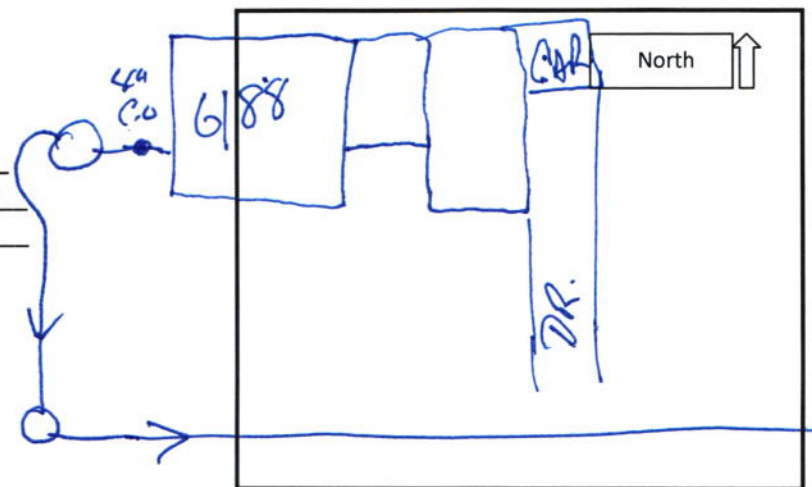

Handwritten notes in the middle left section of the page.

Handwritten notes in the middle right section of the page.



Handwritten notes in the bottom middle section of the page.

5141

Jeff Roberts General Contractors, Inc.

PO Box 453  
Plainfield, IN 46168  
(317) 839-6450

First National Bank  
PLAINFIELD, IN 46168

71-712-749

EZShield™ Check Fraud  
Protection for Business

PAY **FIVE THOUSAND THIRTY DOLLARS** + **.64/100**  
TO THE ORDER OF **FCRWD**

DATE  
**4/15/2014**

AMOUNT  
**5030.64**

COPY

*Jeff Roberts*  
AUTHORIZED SIGNATURE

⑈005141⑈ ⑆074907126⑆ 188 0943 3⑈

Security features. Details on back.

1909