	\ R /	
F(CLEAN TOMORROW TODAY! FALL CREEK REGIONAL WASTE DISTRICT Box 44, Pendleton, Indiana 46064	
10	1-0000294,00	
× Loi-	Nº 000218	
Bar and	Permit No Date	
2.2	Permit Void 90 days from Date of Issuance	
U.	Owner Name Caro Johnson (Ourser)	
	Property Address 2602 gpc 618 gpc St. Lot #	
	Town Angels, IN Zip Code 46048	
	Phone Water Meter 3/W "	
	\$_150°0 Tap on Fee Paid	
	\$ 25" Inspection fee paid	
	Application is hereby made for connection to the Fall Creek Regional Waste District Sewer System for the above listed property - Permit Type: Residential X, Commercial , Industrial, or Governmental/ Institutional . User Information	
	District Ordinance as described in Ordinance 84-2 and 84-3 as amended. Acceptance and approval must be made by the District inspector or his duly authorized representative before backfilling and final connection is made to the main sewer lines. Any violation of applicable regulations will cause all lines and appurtenances in violation to be removed and replaced at the owners expense. The Fall Creek Regional Waste District is responsible for the inspection approval of materials, and installation techniques only. All costs for materials and installation and any liabilities resulting from same is the	1,
	sole responsibility of the property owner.	
	I have read and fully understand the above provisions and agree to comply by said provisions.	
	VID A	
	APPLICANT(S) SIGNATURE	

	INSPECTOR IM	
	Date inspected 0-23-85 Approved X Rejected	
	Reason for rejection	
	Date reinspected Approved Rejected	
	Notes: Size Pipe b' "	1
	Type Pipe PVC	Nor
	Basement Yes No X	.0
	Sump Pump Yes No X	1
	Downspout to Ground Yes Nox	
	Septic Tank Pumped & filled Yes Nox	
	Contractor TASMORE	
	Special Conditions	

16

Rev. 11/84


FAIL CREEK REGIONAL WASTE DISTRICT

Source and the source of the principal states of the source of the sourc

intering the second secon

Description and an end of the second name of the second problem of the second s Second sec

741 - -----

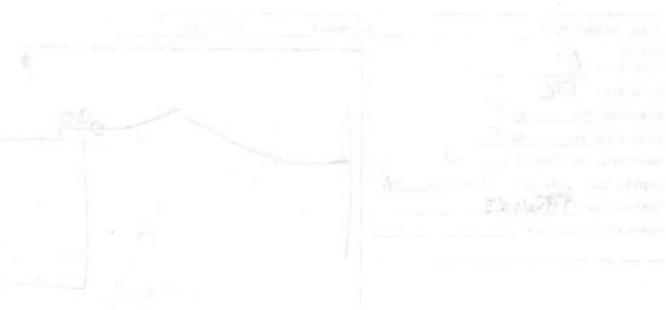

10.00