

add order
on file



FALL CREEK REGIONAL WASTE DISTRICT

9378 S. 650 West PO Box 59
Pendleton, IN 46064-0059 778-7544

8-18615.00

APPLICATION FOR SEWER PERMIT

Nº 2479

Date 10/2/97

Permit Void 90 days from Date of Issuance

Owner Name Leonard Alexander

Property Address 619 N Pendleton Avenue

Lot # _____ P.O. Box _____

Town Pendleton, IN Zip Code 46064

Phone _____ City Water _____ Well ☒

\$ 400.00 Tap on Fee Paid

\$ 1900.00 Capacity Inspection fee paid

pd. 2300.00 on 2/18/99 with check # 7494

Application is hereby made for connection to the Fall Creek Regional Waste District Sewer System for the above listed property - Permit Type: Residential ☒, Commercial _____, Industrial _____, or Governmental/Institutional _____. User Information _____.

All workmanship and materials shall conform to the standards of the District Ordinance as described in Ordinance 84-2 and 84-3 as amended. Acceptance and approval must be made by the District inspector or his duly authorized representative before backfilling and final connection is made to the main sewer lines. Any violation of applicable regulations will cause all lines and appurtenances in violation to be removed and replaced at the owners expense.

The Fall Creek Regional Waste District is responsible for the inspection, approval of materials, and installation techniques only. All costs for materials and installation and any liabilities resulting from same is the sole responsibility of the property owner.

I have read and fully understand the above provisions and agree to comply by said provisions.

APPLICANT(S) SIGNATURE

INSPECTOR B

Date inspected 10-1-97 Approved ☒ Rejected _____

Reason for rejection _____

Date reinspected _____ Approved _____ Rejected _____

Notes:

Size Pipe 4"

Type Pipe PVC

Basement Yes ☒ No _____

Sump Pump Yes _____ No ☒

Downspout to Ground Yes ☒ No _____


Septic Tank Pumped & filled Yes ☒ No _____


Contractor M+M

Special Conditions _____

Existing Home ☒

New Construction _____

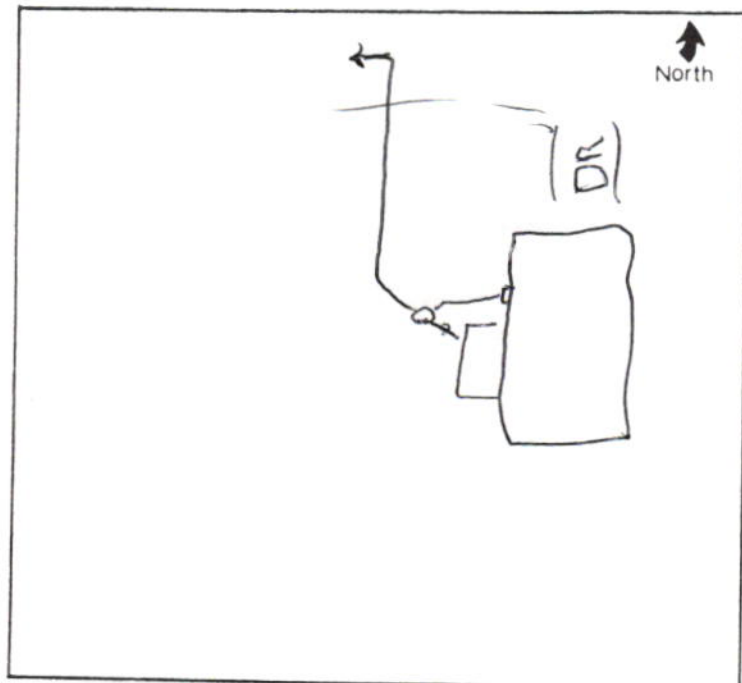

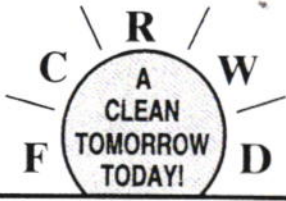

FALL CREEK REGIONAL WASTE DISTRICT

P.O. Box 59 • 9378 S. 650 West • Pendleton, Indiana 46064-0059 • (765) 778-7544

February 10, 1999

Mr. Leonard Alexander
619 N Pendleton Avenue
Pendleton, IN 46064

RE: Tap & Capacity Fees

Dear Mr. Alexander:

Please accept this letter as billing for 619 N Pendleton Avenue, Pendleton.

<u>Tap Fee</u>	<u>Capacity Fee</u>	<u>Total</u>
\$400	\$1900	\$2300

TOTAL AMOUNT DUE: \$2300


J.F. Rowlett
General Manager

JFR/dlw