

Gidw.


PROJECT Phase II SHEET _____ OF _____

SUBJECT _____ DATE 5-7-18

JOB NO 4447

BY Atlas

620 S. Broadway

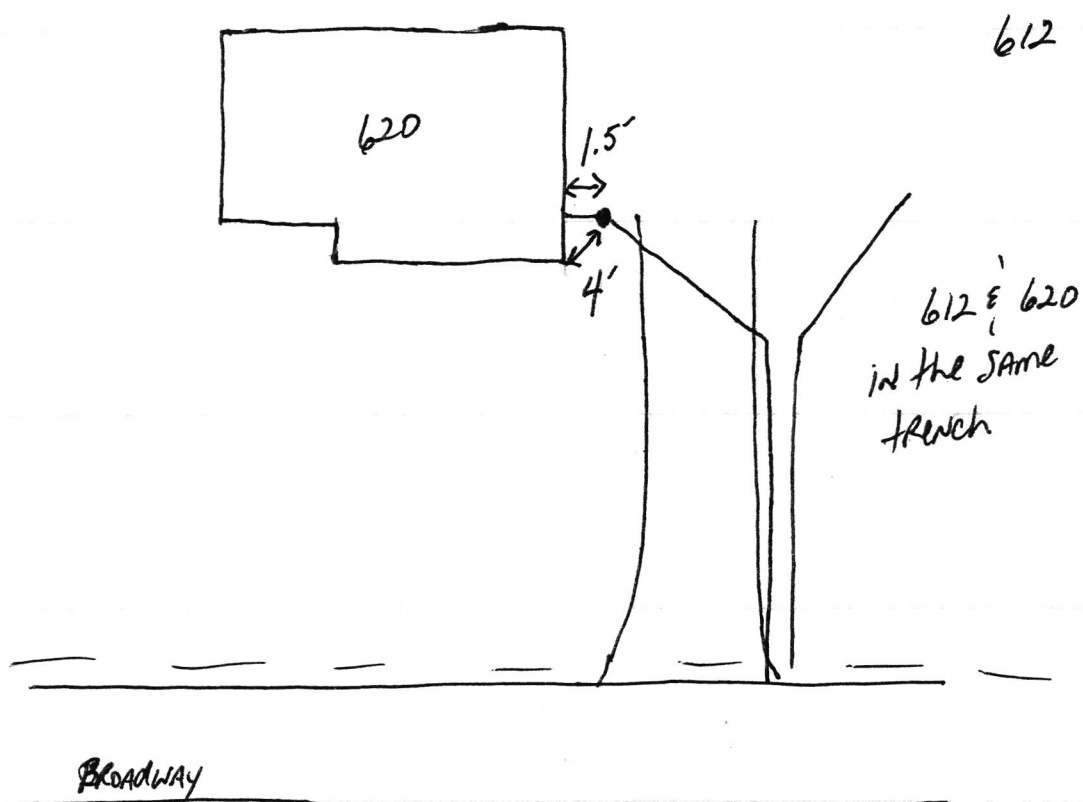

Ward S Broadway

SAP Phase II

5-14-18

