


Gidw.

PROJECT Phase II SHEET _____ OF _____
SUBJECT _____ DATE 6-14-18
JOB NO. 4447
BY Atlas

LOT 1
521 S. Silver

← N

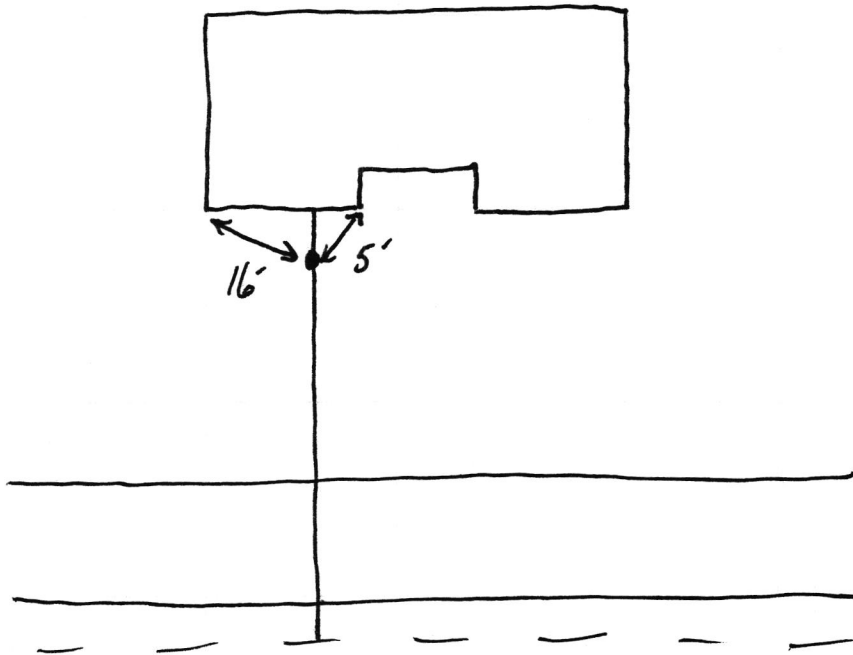

Lea Silver

SRF Phase II

Lea.19.18

