

9378 S 650 WEST, P.O. BOX 59, PENDLETON, IN 46064

**765-778-7544**

## AGREEMENT FOR SANITARY SEWER SERVICE

This Agreement made and entered into this 25 day of November, 2003, between FALL CREEK REGIONAL WASTE DISTRICT ("District") and Mike Barker ("Applicant") regarding the provision of sanitary sewer service, and the assignment of capacity in, and connection to, the District's facilities for the premises located at Lot 7 Fox Run Pendleton.

**NOW THEREFORE**, the parties, in consideration of the mutual promises set out in this Agreement, the receipt and sufficiency of which is hereby acknowledged, agree as follows:

1. The Applicant agrees that all workmanship and materials shall conform to all District ordinances and the District's construction standards. District must accept and approve all work and materials before backfilling and final connection is made to the sewer mains. Any violation of this provision will cause all lines and appurtenances in violation to be removed and replaced at the Applicant's expense.
2. The District shall have the right to enter upon the Applicant's premises at all reasonable times to inspect, repair, or replace any equipment used in connection with the District's service or which has an impact on said service.
3. The Applicant shall be responsible for all monthly user rates, capacity charges, and tap fees. The failure to pay any rate charge or fee may result in a lien against the property and/or the termination of service to the property, the cost of which will be borne by Applicant, including, but not limited to, all attorney's fees and collection costs.
4. The District shall not be responsible for any damages as a result of any failure to supply service unless said damages are due to default, neglect or culpability on the part of the District.
5. If there is an available sanitary sewer within three hundred (300) feet of the property line, the property owner shall be required to connect to the District's sanitary sewer system.
6. The Applicant and District agree that the provision of sanitary sewer service touches and concerns the property and the terms of this Agreement bind the District and Applicant and their heirs, executors, administrators, personal representatives, successors, agents, attorneys, assigns, designees, and transferees.

The parties hereto have read and fully understand the above provisions and agree to comply with said provisions.

FALL CREEK REGIONAL WASTE DISTRICT  
*Leresa H. Norton*  
 Signature

APPLICANT  
Harold Reffey  
Signature

[illegible]

SUBSCRIBED and sworn to before me this 25th day of November, 200 3

My Commission Expires:  
4-19-2008

Signature Teresa K. Hutton  
Printed Teresa K. Hutton

Notary Public  
Resident of Madison County

\*\*\*\*\*  
INSPECTOR Be DATE INSPECTED 6-204 APPROVED ✓ REJECTED \_\_\_\_\_

REASON FOR REJECTION

| DATE REINSPECTED | APPROVED | REJECTED |
|------------------|----------|----------|
|------------------|----------|----------|

NOTES: SIZE PIPE 4" / 1.5 TYPE PIPE PVC

BASEMENT YES ☒ NO

SUMP PUMP YES NO

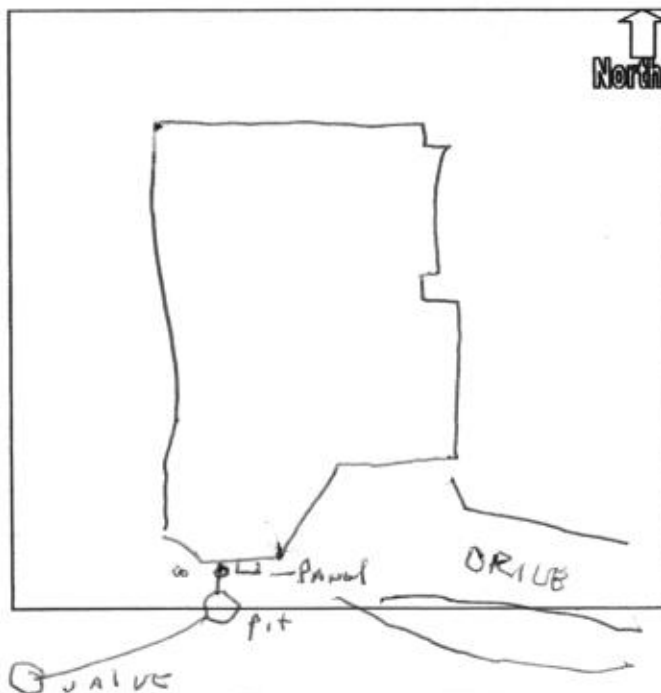
DOWNSPOUT TO GROUND YES ☒ NO ☐

SEPTIC TANK PUMPED & FILLED YES NO ☒

CONTRACTOR Long + Kosser

### SPECIAL CONDITIONS

## EXISTING HOME

NEW CONSTRUCTION 

RIFFEY BUILDERS INC.  
5205 S. 525W  
PENDLETON, IN 46064-9174

71-553/749  
7903383

960

DATE 11-25-03

PAY TO THE  
ORDER OF

Trall C. Regional Waste

\$ 2635.<sup>00</sup>

Two Thousand Six Hundred Thirty Five

DOLLARS



Security Features  
Included  
Details on Back



Madison  
Community Bank

MEMO

Permit (Bocher)

William H Rife

MP

⑆074905539⑆ 790 338 3⑈ 0960

LONG & KOFFER, INC.  
1795 W. HUNTSVILLE RD.  
PENDLETON, INDIANA 46064  
765/778-5219

NATIONAL CITY BANK OF INDIANA  
INDIANAPOLIS, INDIANA 46255  
20-6/740

MP  
2210

6/2/2004

PAY TO THE ORDER OF Fall Creek Regional Waste District


\$ \*\*1,549.72

One Thousand Five Hundred Forty-Nine and 72/100\*\*\*\*\*1

DOLLARS

Fall Creek Regional Waste District

MEMO: 



⑈002210⑈ ⑆074000065⑆ 501977276⑈

Commodity Signature Padlock on back