



FALL CREEK REGIONAL WASTE DISTRICT

9378 S. 650 West PO Box 59  
Pendleton, IN 46064-0059 778-7544

add order  
on file

26-08120.00

APPLICATION FOR SEWER PERMIT

Nº 2733

Date 2-9-2000

Permit Void 90 days from Date of Issuance

Owner Name Riffey Builders - Greg + Mary Phillips  
Property Address 6254 N. Foster's Branch Foster's Branch Woods  
Lot # 13 P.O. Box \_\_\_\_\_  
Town \_\_\_\_\_, IN Zip Code \_\_\_\_\_  
Phone (765) 778-3177 City Water \_\_\_\_\_ Well \_\_\_\_\_  
\$ 2556.00 Tap on Fee Paid Grinder, unit paid for  
\$ \_\_\_\_\_ Inspection fee paid Long & Kopper 1024.80

Application is hereby made for connection to the Fall Creek Regional Waste District Sewer System for the above listed property - Permit Type: Residential ☒, Commercial \_\_\_\_\_, Industrial \_\_\_\_\_, or Governmental/Institutional \_\_\_\_\_. User Information \_\_\_\_\_.

All workmanship and materials shall conform to the standards of the District Ordinance as described in Ordinance 84-2 and 84-3 as amended. Acceptance and approval must be made by the District inspector or his duly authorized representative before backfilling and final connection is made to the main sewer lines. Any violation of applicable regulations will cause all lines and appurtenances in violation to be removed and replaced at the owners expense.

The Fall Creek Regional Waste District is responsible for the inspection, approval of materials, and installation techniques only. All costs for materials and installation and any liabilities resulting from same is the sole responsibility of the property owner.

I have read and fully understand the above provisions and agree to comply by said provisions.


Harold E. Riffey  
APPLICANT(S) SIGNATURE

\*\*\*\*\*  
INSPECTOR B

Date inspected 5-19-00 Approved ☒ Rejected \_\_\_\_\_  
Reason for rejection \_\_\_\_\_

Date reinspected \_\_\_\_\_ Approved \_\_\_\_\_ Rejected \_\_\_\_\_

Notes:  
Size Pipe 4"  
Type Pipe PVC  
Basement Yes ☒ No \_\_\_\_\_  
Sump Pump Yes \_\_\_\_\_ No ☒  
Downspout to Ground Yes ☒ No \_\_\_\_\_  
Septic Tank Pumped & filled Yes ☒ No \_\_\_\_\_  
Contractor Long & Kopper  
Special Conditions \_\_\_\_\_  
Existing Home \_\_\_\_\_  
New Construction ☒

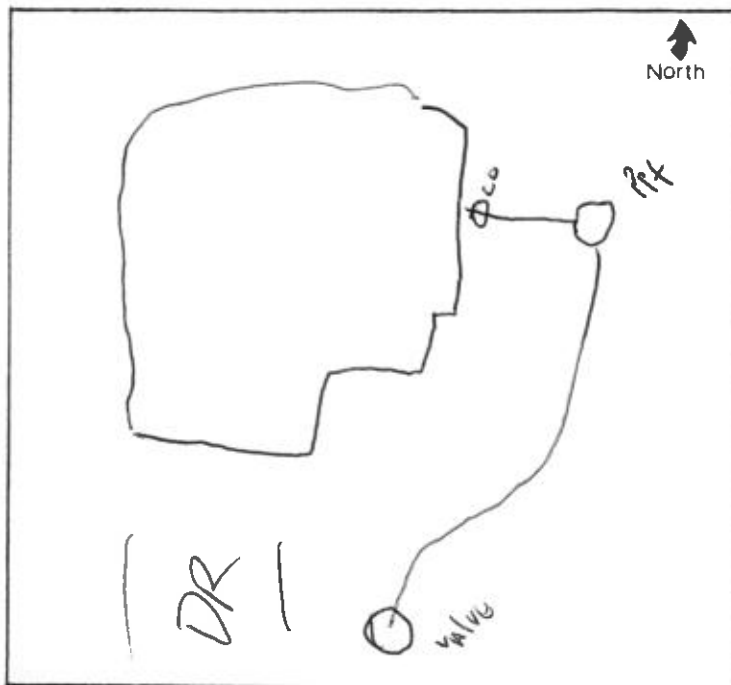

LONG & KOFFER, INC.  
1795 W. HUNTSVILLE RD.  
PENDLETON, INDIANA 46064  
765/778-5219

NATIONAL CITY BANK  
INDIANAPOLIS, INDIANA 46235  
20-6740

PAY TO THE  
ORDER OF

Fall Creek Regional Waste District

\$ 1024.80

One - Thousand Twenty - four Dollars and

80/100

DOLLARS

MEMO:



⑈001114⑈ ⑆074000065⑆ 501977276⑈

SECURITY FEATURES: MICRO PRINT TOP & BOTTOM BORDERS - COLORED PATTERN - ARTIFICIAL WATERMARK ON REVERSE SIDE - MISSING FEATURE INDICATES A COPY