

26-09130.00



FALL CREEK REGIONAL WASTE DISTRICT

9378 S. 650 West PO Box 59
Pendleton, IN 46064-0059 778-7544

Contractor: Derry Fredricks

APPLICATION FOR SEWER PERMIT

Nº 2879

Date 9/8/00

Permit Void 90 days from Date of Issuance

Owner Name DAVID A Derry

Property Address 6255 S. Supreme Ct.

Lot # _____ P.O. Box _____

Town Pendleton, IN Zip Code 46064

Phone 765-778-5220 City Water _____ Well ☒

\$ 2550.00 Tap on Fee Paid Lot 27

\$ N/A Inspection fee paid

Application is hereby made for connection to the Fall Creek Regional Waste District Sewer System for the above listed property - Permit Type: Residential ☒, Commercial _____, Industrial _____, or Governmental/Institutional _____. User Information _____.

All workmanship and materials shall conform to the standards of the District Ordinance as described in Ordinance 84-2 and 84-3 as amended. Acceptance and approval must be made by the District inspector or his duly authorized representative before backfilling and final connection is made to the main sewer lines. Any violation of applicable regulations will cause all lines and appurtenances in violation to be removed and replaced at the owners expense.

The Fall Creek Regional Waste District is responsible for the inspection, approval of materials, and installation techniques only. All costs for materials and installation and any liabilities resulting from same is the sole responsibility of the property owner.

I have read and fully understand the above provisions and agree to comply by said provisions.

[Signature]
APPLICANT(S) SIGNATURE

INSPECTOR Tim

Date inspected 11/8 Approved _____ Rejected _____

Reason for rejection _____

Date reinspected _____ Approved _____ Rejected _____

Notes:

Size Pipe 6"

Type Pipe SDR 26

Basement Yes ☐ No ☒

Sump Pump Yes ☐ No ☒

Downspout to Ground Yes ☒ No ☐


Septic Tank Pumped & filled Yes ☒ No ☐

Contractor FREDRICKS CONST.

Special Conditions _____

Existing Home ☒

New Construction _____

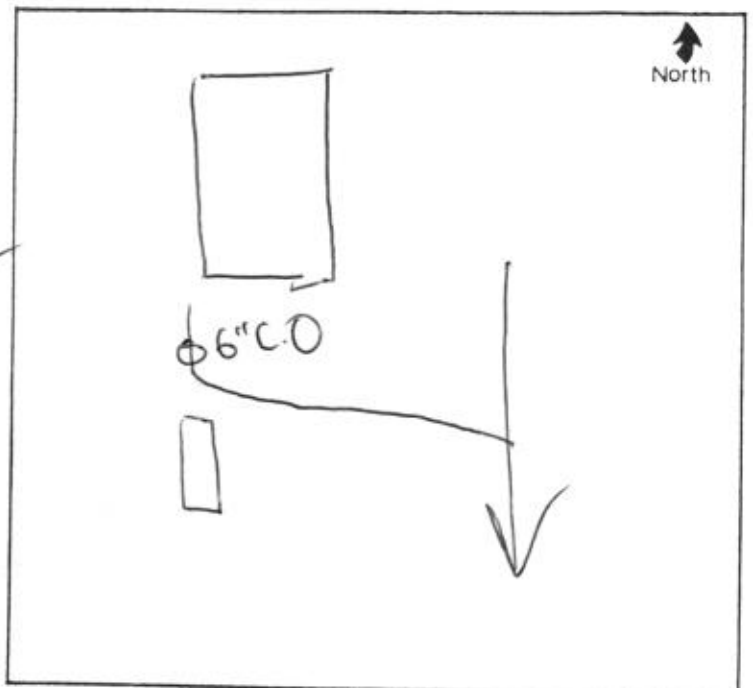



DAVID A. DOERR 1/99
MARYA J. DOERR
6255 S SUPREME COURT PH. 765-778-5220
PENDLETON, IN 46064

20-7043/2740
170009850

No.

1302

~~DOERR~~ 9/8/00

Pay to the order of

Fall Creek Reg. Waste Dis. \$ 2556⁰⁰
Twenty five hundred fifty-six and 00/100

~~DOERR~~

Security features
including
Digital on back



FIRST INDIANA® BANK
INDIANAPOLIS, INDIANA 46204

~~MEMO~~

TAP/CAP FEE

[Signature]

MP

⑆ 274070439⑆ 170009850⑆ 1302

ANTIQUE