



# FALL CREEK REGIONAL WASTE DISTRICT

9378 S. 650 West PO Box 59  
Pendleton, IN 46064-0059 778-7544

26-09140.00

add order  
on file

## APPLICATION FOR SEWER PERMIT

Nº 2770

Date May 3, 2000

Permit Void 90 days from Date of Issuance

Owner Name Todd and Diane Hampshire

Property Address 6260 Supreme Ct.

Lot # \_\_\_\_\_ P.O. Box \_\_\_\_\_

Town Pendleton

IN Zip Code 46064

Phone 765 7781434

City Water \_\_\_\_\_ Well X

\$ 400.00 Tap on Fee Paid

\$ 2156.00 Inspection fee paid Lot 28

Application is hereby made for connection to the Fall Creek Regional Waste District Sewer System for the above listed property - Permit Type: Residential X, Commercial \_\_\_\_\_, Industrial \_\_\_\_\_, or Governmental/Institutional \_\_\_\_\_. User Information \_\_\_\_\_.

All workmanship and materials shall conform to the standards of the District Ordinance as described in Ordinance 84-2 and 84-3 as amended. Acceptance and approval must be made by the District inspector or his duly authorized representative before backfilling and final connection is made to the main sewer lines. Any violation of applicable regulations will cause all lines and appurtenances in violation to be removed and replaced at the owners expense.

The Fall Creek Regional Waste District is responsible for the inspection, approval of materials, and installation techniques only. All costs for materials and installation and any liabilities resulting from same is the sole responsibility of the property owner.

I have read and fully understand the above provisions and agree to comply by said provisions.

Diane M. Hampshire

APPLICANT(S) SIGNATURE

INSPECTOR Dor

Date inspected 5-8-00

Approved ✓

Rejected \_\_\_\_\_

Reason for rejection \_\_\_\_\_

Date reinspected \_\_\_\_\_

Approved \_\_\_\_\_

Rejected \_\_\_\_\_

Notes:

Size Pipe 6 "

Type Pipe PVC 35

Basement Yes \_\_\_\_\_ No ✓

Sump Pump Yes \_\_\_\_\_ No ✓

Downspout to Ground Yes ✓ No \_\_\_\_\_

Septic Tank Pumped & filled Yes ✓ No \_\_\_\_\_


Contractor Jersey Hendrick

Special Conditions USED EXISTING

4" C.O. AT HOUSE

Existing Home ✓

New Construction \_\_\_\_\_

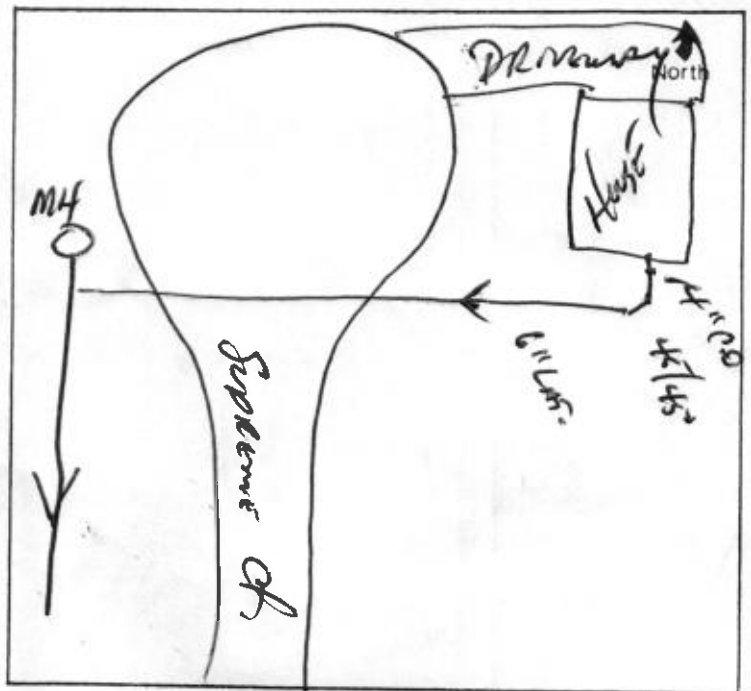

692

62

9378 S. CR 650 W.  
P.O. Box 59  
Pendleton, IN 46064  
Phone: 765-778-7544

**INVOICE**

Name Todd Hampshire Acct # \_\_\_\_\_  
Address 6260 S Supreme Court  
City Pendleton State IN Zip 46064  
Phone \_\_\_\_\_

Project Area #	D
W.O. #	9915
Due Date	90 days

QTY	DESCRIPTION	UNIT PRICE	TOTAL
1	tap fee	\$400.00	\$400.00
1	capacity fee	\$2,156.00	\$2,156.00
		Sub-Total	\$2,556.00

DATE	PAYMENT	CHECK NUMBER	AMOUNT
		<b>Sub-Total</b>	<b>\$0.00</b>

<b>TOTAL</b>	<b>\$2,556.00</b>
--------------	-------------------

*Detach bottom portion and return with payment*

**Cut here**

Name Todd Hampshire Acct # \_\_\_\_\_  
Address 6260 S Supreme Court  
City Pendleton State IN Zip 46064  
Phone \_\_\_\_\_

Project Area #	D
W.O. #	9915
Due Date	90 days

Amount Due	\$2,556.00
------------	------------

TODD C. HAMPSHIRE  
DIANE M. HAMPSHIRE  
6260 SUPREME CT PH. 765-778-1434  
PENDLETON, IN 46064

DATE May 3, 2000 20-6/740 308

PAY TO THE  
ORDER OF

FCRWD

\$ 2556.<sup>00</sup>/<sub>100</sub>

Two thousand five hundred fifty six and <sup>00</sup>/<sub>100</sub> DOLLARS Security fee included. Details on back

**National City.**

National City Bank of Indiana  
Anderson, Indiana

FOR

Diane M. Hampshire

⑆074000065⑆

698126121⑆

0615