

26-09080.00  
add order on file  
**FALL CREEK REGIONAL WASTE DISTRICT**9378 S. 650 West PO Box 59  
Pendleton, IN 46064-0059 778-7544

## APPLICATION FOR SEWER PERMIT

Nº 2781

Date 5.23.00

Permit Void 90 days from Date of Issuance


Owner Name JOHN DAUGHERTYProperty Address 6262 SENATE CTLot # 19 P.O. Box \_\_\_\_\_Town PENDLETON, IN Zip Code 46064Phone 778-7549 City Water \_\_\_\_\_ Well ☒\$ 2556.00 Tap on Fee Paid and capacity\$ \_\_\_\_\_ Inspection fee paid contractor - Merry Fredericks

Application is hereby made for connection to the Fall Creek Regional Waste District Sewer System for the above listed property - Permit Type: Residential ☒, Commercial \_\_\_\_\_, Industrial \_\_\_\_\_, or Governmental/Institutional \_\_\_\_\_. User Information \_\_\_\_\_.

All workmanship and materials shall conform to the standards of the District Ordinance as described in Ordinance 84-2 and 84-3 as amended. Acceptance and approval must be made by the District inspector or his duly authorized representative before backfilling and final connection is made to the main sewer lines. Any violation of applicable regulations will cause all lines and appurtenances in violation to be removed and replaced at the owners expense.

The Fall Creek Regional Waste District is responsible for the inspection, approval of materials, and installation techniques only. All costs for materials and installation and any liabilities resulting from same is the sole responsibility of the property owner.

I have read and fully understand the above provisions and agree to comply by said provisions.

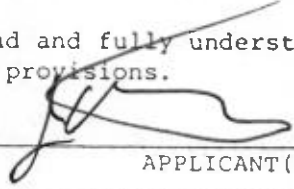  
APPLICANT(S) SIGNATURE\*\*\*\*\*  
INSPECTOR Date inspected 5.24.00 Approved ☒ Rejected \_\_\_\_\_

Reason for rejection \_\_\_\_\_

Date reinspected \_\_\_\_\_ Approved \_\_\_\_\_ Rejected \_\_\_\_\_


## Notes:

Size Pipe 6"Type Pipe WC 35Basement Yes ☒ No ☒Sump Pump Yes ☒ No ☒Downspout to Ground Yes ☒ No ☒Septic Tank Pumped & filled Yes ☒ No ☒Contractor Merry Fredericks

Special Conditions \_\_\_\_\_

Existing Home ☒

New Construction \_\_\_\_\_

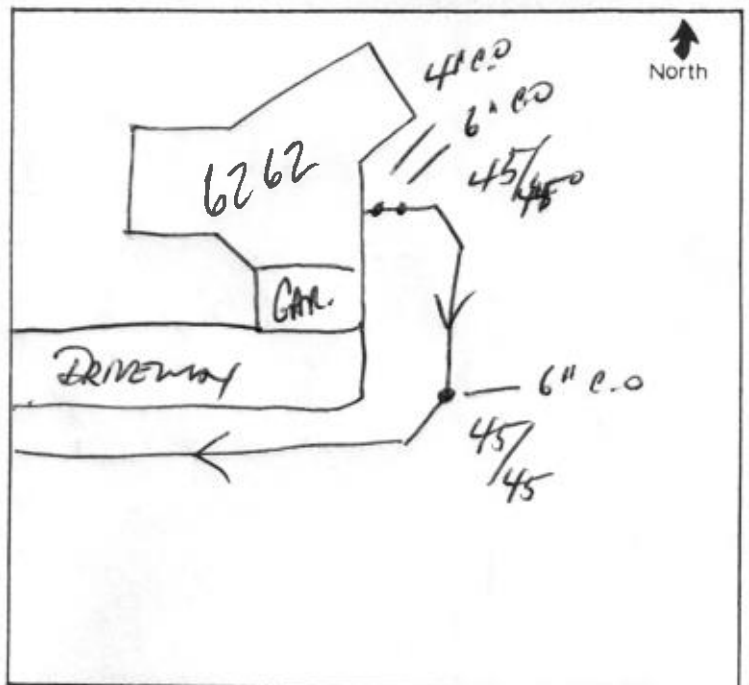



9378 S. CR 650 W.  
P.O. Box 59  
Pendleton, IN 46064  
Phone: 765-778-7544

**INVOICE**

Name John Daugherty Acct # \_\_\_\_\_  
Address 6262 S Senate Court  
City Pendleton State IN Zip 46064  
Phone \_\_\_\_\_

QTY	DESCRIPTION	UNIT PRICE	TOTAL
1	tap fee	\$400.00	\$400.00
1	capacity fee	\$2,156.00	\$2,156.00
		Sub-Total	\$2,556.00

DATE	PAYMENT	CHECK NUMBER	AMOUNT
		<b>Sub-Total</b>	<b>\$0.00</b>

*Detach bottom portion and return with payment*

**Cut here**

Name John Daugherty Acct # \_\_\_\_\_  
Address 6262 S Senate Court  
City Pendleton State IN Zip 46064  
Phone \_\_\_\_\_ 0

Project Area # D  
W.O. # 9915  
Due Date 90 days

Amount Due	\$2,556.00
------------	------------