



FALL CREEK REGIONAL WASTE DISTRICT

9378 S. 650 West PO Box 59
Pendleton, IN 46064-0059 778-7544

add order
on file

22-28505.00

APPLICATION FOR SEWER PERMIT

Nº 2085

Date May 18, 1994

Permit Void 90 days from Date of Issuance

Owner Name John Sorlie

Property Address 6264 S. Red Fox Rd.

Lot # 42 N.W.E. II P.O. Box _____

Town Pendleton, IN Zip Code 46064

Phone _____ City Water _____ Well ☒

\$ 700.00 Tap on Fee Paid ~~Amount~~

\$ 25.00 Inspection fee paid

Application is hereby made for connection to the Fall Creek Regional Waste District Sewer System for the above listed property - Permit Type: Residential ☒, Commercial _____, Industrial _____, or Governmental/Institutional _____. User Information _____.

All workmanship and materials shall conform to the standards of the District Ordinance as described in Ordinance 84-2 and 84-3 as amended. Acceptance and approval must be made by the District inspector or his duly authorized representative before backfilling and final connection is made to the main sewer lines. Any violation of applicable regulations will cause all lines and appurtenances in violation to be removed and replaced at the owners expense.

The Fall Creek Regional Waste District is responsible for the inspection, approval of materials, and installation techniques only. All costs for materials and installation and any liabilities resulting from same is the sole responsibility of the property owner.

I have read and fully understand the above provisions and agree to comply by said provisions.

[Signature]
APPLICANT(S) SIGNATURE

INSPECTOR TIM

Date inspected 5-18-94 Approved ☒ Rejected _____

Reason for rejection _____

Date reinspected _____ Approved _____ Rejected _____

Notes:

Size Pipe 6"

Type Pipe SDR35

Basement Yes _____ No ☒

Sump Pump Yes _____ No ☒

Downspout to Ground Yes _____ No _____

Septic Tank Pumped & filled Yes _____ No _____

Contractor _____


Special Conditions Foundation was

only work done

Existing Home _____

New Construction ☒

Contractor finished
up bedding pipe with
Pea Gravel

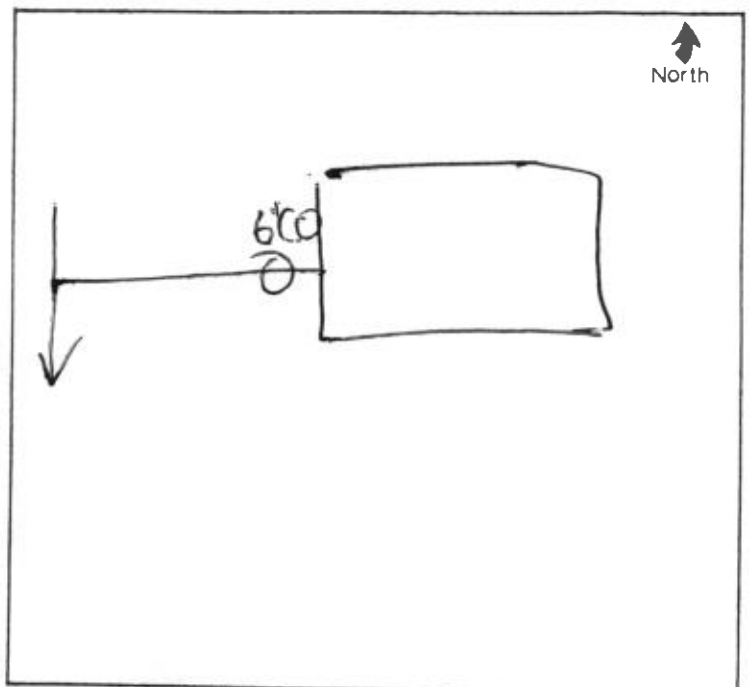

not given
with

PLEASE PRINT NAME AND ADDRESS



2005

Page 10


[Faint, mostly illegible handwritten text, possibly a list or notes.]

[Handwritten signature or name.]

100

2-18-04

2003

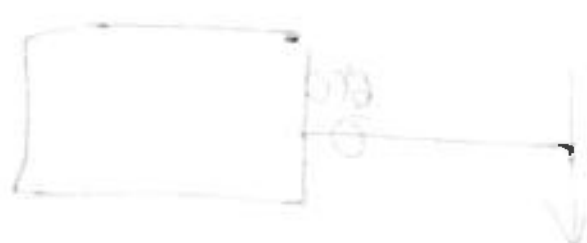

Temperature

only one case

✓
no record file with
contractor finished
Per Contract

IMPROVEMENT LOCATION PERMIT

COUNTY OF MADISON, INDIANA

Second Floor — Madison County Government Center
Anderson, Indiana 46016
PHONE 641-9541

PERMIT NO. 94-104
DATE 4-4-94

ISSUED TO: John Salig
TO PERMIT Driv
ON PREMISES LOCATED: LOT NO. 42 IN Nichony Hills East II
ADDRESS: 6264 S. Red Fox Road
Fall Creek TOWNSHIP, Mark Patton

BUILDING INSPECTOR
County of Madison, Indiana

NOTICE

POST THIS PERMIT IN A CONSPICUOUS LOCATION ON THE PREMISES
IF ANY CHANGES OR DEVIATIONS ARE MADE FROM THE ORIGINAL
APPLICATION, A NEW PERMIT IS REQUIRED.
PERMIT MUST REMAIN POSTED UNTIL STRUCTURE COMPLETE

THIS LOCATION IMPROVEMENT PERMIT HAS BEEN ISSUED ON THIS
BUILDING IN ACCORDANCE WITH THE COMPREHENSIVE PLAN
ORDINANCE. PERMIT IS VOID AFTER 18 MONTHS FROM DATE UNLESS
RENEWED.