

22-28507.00

add order
on file

FALL CREEK REGIONAL WASTE DISTRICT

9378 S. 650 West PO Box 59
Pendleton, IN 46064-0059 778-7544

APPLICATION FOR SEWER PERMIT

Nº 2079

Date

4/25/94

Permit Void 90 days from Date of Issuance

Owner Name

Harold J. Ray John Phillips

Property Address

6267 Red Fox Road

Lot #

50 - Hickory Hills

P.O. Box

Town

Pendleton

IN

Zip Code

46064

Phone

City Water

Well

✓

\$

400.00

Tap on Fee Paid

availability fee 2,000.00

\$

Inspection fee paid

interior line fee 1243.50

Application is hereby made for connection to the Fall Creek Regional Waste District Sewer System for the above listed property - Permit Type: Residential ☒, Commercial ☐, Industrial ☐, or Governmental/Institutional ☐. User Information _____.

All workmanship and materials shall conform to the standards of the District Ordinance as described in Ordinance 84-2 and 84-3 as amended. Acceptance and approval must be made by the District inspector or his duly authorized representative before backfilling and final connection is made to the main sewer lines. Any violation of applicable regulations will cause all lines and appurtenances in violation to be removed and replaced at the owners expense.

The Fall Creek Regional Waste District is responsible for the inspection, approval of materials, and installation techniques only. All costs for materials and installation and any liabilities resulting from same is the sole responsibility of the property owner.

I have read and fully understand the above provisions and agree to comply by said provisions

APPLICANT(S) SIGNATURE

INSPECTOR

BEN

Date inspected Dec 96

Approved

✓

Rejected

Reason for rejection

Date reinspected

Approved

Rejected

Notes:

Size Pipe 6" S


Type Pipe SDR35

Basement Yes ☒ No ☐Sump Pump Yes ☐ No ☒Downspout to Ground Yes ☒ No ☐Septic Tank Pumped & filled Yes ☐ No ☐

Contractor Dick Godbey

Special Conditions

Existing Home

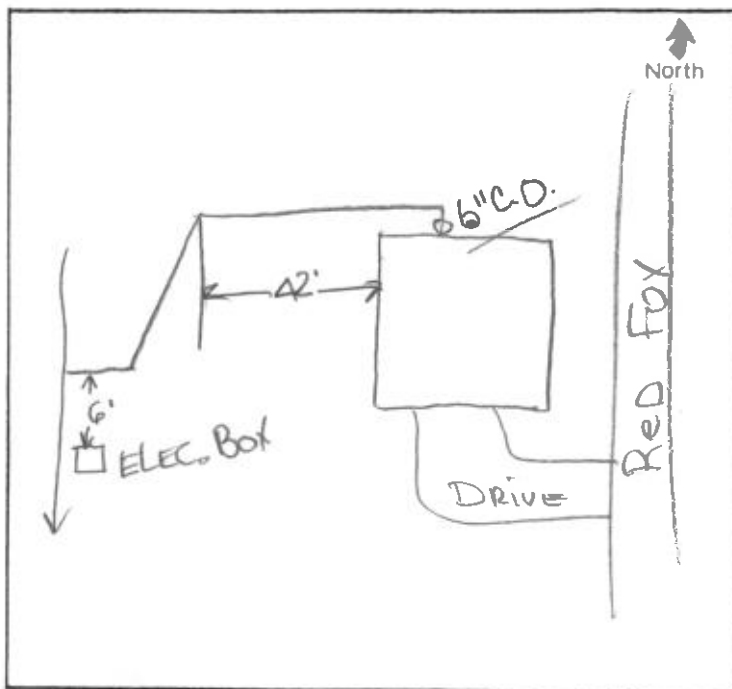New Construction ☒



FALL CREEK REGIONAL WASTE DISTRICT

9378 S. 650 West PO Box 59
Pendleton, IN 46064-0059 778-7544

add order
on file

John Phillips

APPLICATION FOR SEWER PERMIT

Nº 2079

Date 4/25/94

days from Date of Issuance

Harold A. Ray John Phillips

Property Address 6267 Red Fox Road

Lot # 50 - Hickory Hills P.O. Box _____

Town Pendleton IN Zip Code 46064

Phone _____ City Water _____ Well ☒

\$ 400.00 12/20/96 Tap on Fee Paid availability fee 2,000.00

\$ _____ Inspection fee paid interior line fee 1243.50

Application is hereby made for connection to the Fall Creek Regional Waste District Sewer System for the above listed property - Permit Type: Residential ☒, Commercial _____, Industrial _____, or Governmental/Institutional _____. User Information _____.

All workmanship and materials shall conform to the standards of the District Ordinance as described in Ordinance 84-2 and 84-3 as amended. Acceptance and approval must be made by the District inspector or his duly authorized representative before backfilling and final connection is made to the main sewer lines. Any violation of applicable regulations will cause all lines and appurtenances in violation to be removed and replaced at the owners expense.

The Fall Creek Regional Waste District is responsible for the inspection, approval of materials, and installation techniques only. All costs for materials and installation and any liabilities resulting from same is the sole responsibility of the property owner.

I have read and fully understand the above provisions and agree to comply by said provisions.

Harold A. Ray

APPLICANT(S) SIGNATURE

INSPECTOR B

Date inspected Dec 1996 Approved ☒ Rejected _____

Reason for rejection _____

Date reinspected _____ Approved _____ Rejected _____

Notes:

Size Pipe 6 "

Type Pipe PVC

Basement Yes ☒ No _____

Sump Pump Yes _____ No ☒

Downspout to Ground Yes ☒ No _____


Septic Tank Pumped & filled Yes ☒ No _____

Contractor Godbey

Special Conditions _____

Existing Home _____

New Construction ☒

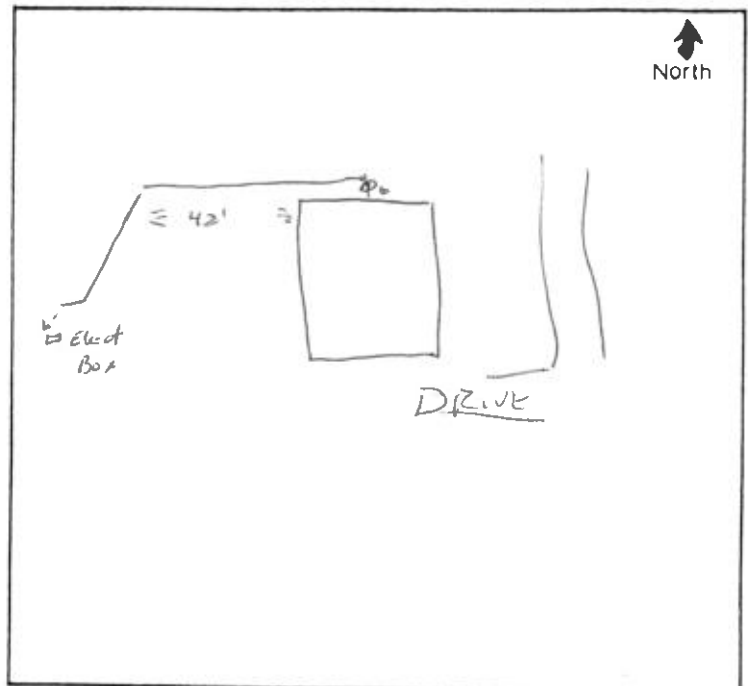

22-28507.00

add order on file



FALL CREEK REGIONAL WASTE DISTRICT

9378 S. 650 West PO Box 59
Pendleton, IN 46064-0059 778-7544

APPLICATION FOR SEWER PERMIT

Nº 2079

Date 4/25/94

Permit Void 90 days from Date of Issuance

Owner Name Harold J. Ray John Phillips

Property Address 6267 Red Fox Road

Lot # 50 - Hickory Hills P.O. Box

Town Pendleton, IN Zip Code 46064

Phone City Water Well

\$ 400.00 12/20/96 Tap on Fee Paid availability fee 2,000.00

\$ Inspection fee paid interior line fee 1243.50

Application is hereby made for connection to the Fall Creek Regional Waste District Sewer System for the above listed property - Permit Type: Residential, Commercial, Industrial, or Governmental/Institutional. User Information

All workmanship and materials shall conform to the standards of the District Ordinance as described in Ordinance 84-2 and 84-3 as amended. Acceptance and approval must be made by the District inspector or his duly authorized representative before backfilling and final connection is made to the main sewer lines. Any violation of applicable regulations will cause all lines and appurtenances in violation to be removed and replaced at the owners expense.

The Fall Creek Regional Waste District is responsible for the inspection, approval of materials, and installation techniques only. All costs for materials and installation and any liabilities resulting from same is the sole responsibility of the property owner.

I have read and fully understand the above provisions and agree to comply by said provisions

Signature of Harold J. Ray

APPLICANT(S) SIGNATURE

INSPECTOR BEN

Date inspected Dec 96 Approved Rejected

Reason for rejection

Date reinspected Approved Rejected

Notes:
Size Pipe 6" s
Type Pipe SDR35
Basement Yes No
Sump Pump Yes No
Downspout to Ground Yes No
Septic Tank Pumped & filled Yes No
Contractor Dick Godbey
Special Conditions

Existing Home
New Construction

