



FALL CREEK REGIONAL WASTE DISTRICT

9378 S. 650 West PO Box 59
Pendleton, IN 46064-0059 778-7544

26-09320.00 add order
on file

APPLICATION FOR SEWER PERMIT

Nº 2758

Date

4-19-00

Permit Void 90 days from Date of Issuance

Owner Name Scott Stump

Property Address 6267 S. Senate Court

Lot # 56 P.O. Box _____

Town Pendleton, IN Zip Code 46064

Phone _____ City Water _____ Well _____

\$ 2556.00 Tap on Fee Paid

\$ _____ Inspection fee paid

Application is hereby made for connection to the Fall Creek Regional Waste District Sewer System for the above listed property - Permit Type: Residential ☒, Commercial _____, Industrial _____, or Governmental/Institutional _____. User Information _____

All workmanship and materials shall conform to the standards of the District Ordinance as described in Ordinance 84-2 and 84-3 as amended. Acceptance and approval must be made by the District inspector or his duly authorized representative before backfilling and final connection is made to the main sewer lines. Any violation of applicable regulations will cause all lines and appurtenances in violation to be removed and replaced at the owners expense.

The Fall Creek Regional Waste District is responsible for the inspection, approval of materials, and installation techniques only. All costs for materials and installation and any liabilities resulting from same is the sole responsibility of the property owner.

I have read and fully understand the above provisions and agree to comply by said provisions.

Harold E. Riffey
APPLICANT(S) SIGNATURE

INSPECTOR [Signature]

Date inspected 5-4-00 Approved ☒ Rejected _____

Reason for rejection _____

Date reinspected _____ Approved _____ Rejected _____

Notes:

Size Pipe 6"

Type Pipe PVC

Basement Yes No ☒

Sump Pump Yes No ☒

Downspout to Ground Yes ☒ No


Septic Tank Pumped & filled Yes ☒ No

Contractor John Long

Special Conditions _____

Existing Home _____

New Construction ☒

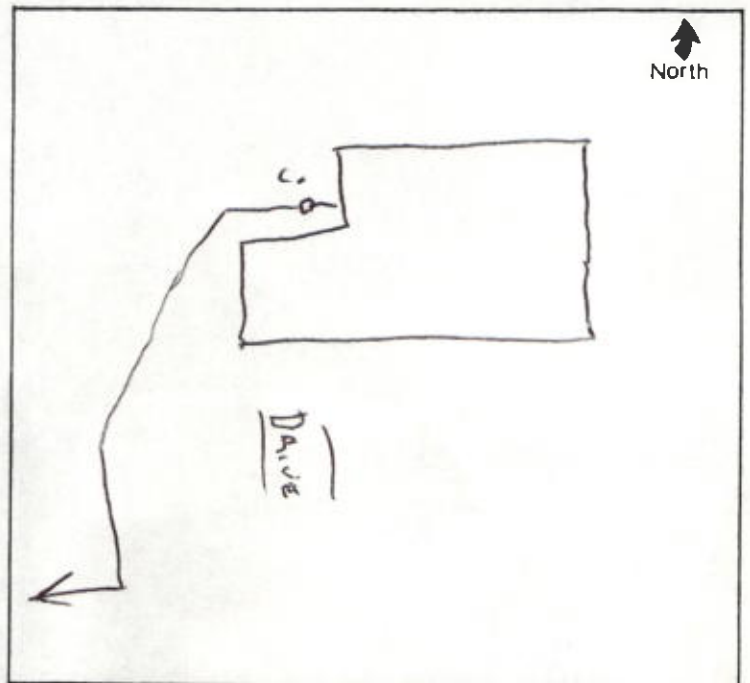

24-6230.00 a 1/2 inch
copy

FALL CREEK REGIONAL WASTE DISTRICT
2012 E. 62nd Street, 20 West 20
PO Box 100, IN 46061-0001 100-1004



3258

APPLICANT FOR WASTE PERMIT

4-19-00

Project Name: Scott's Stump
Project Address: West 2 State Court
City: West
County: Scott
State: Ill
Zip: 62501-0001

Industrial or Commercial Use: Yes
Residential Use: No
Agricultural Use: No
Municipal Use: No

All information and materials shall remain the property of the District. The District reserves the right to inspect the site at any time. The District shall not be responsible for the accuracy of the information provided by the applicant. The District shall not be responsible for the results of the permit process.

The Fall Creek Regional Waste District is responsible for the collection, transport, and disposal of solid waste. The District shall not be responsible for the results of the permit process.

It is the policy of the District to provide a safe and healthy environment for the community. The District shall not be responsible for the results of the permit process.

Signature: Theresa E. Papp
Title: Director

Signature: [Signature]
Title: Director

Date: 2-4-00

Project No: 3258

Project Address: West 2 State Court

City: West

County: Scott

State: Ill

Zip: 62501-0001


Project Name: Scott's Stump

Project Address: West 2 State Court

City: West

County: Scott

State: Ill

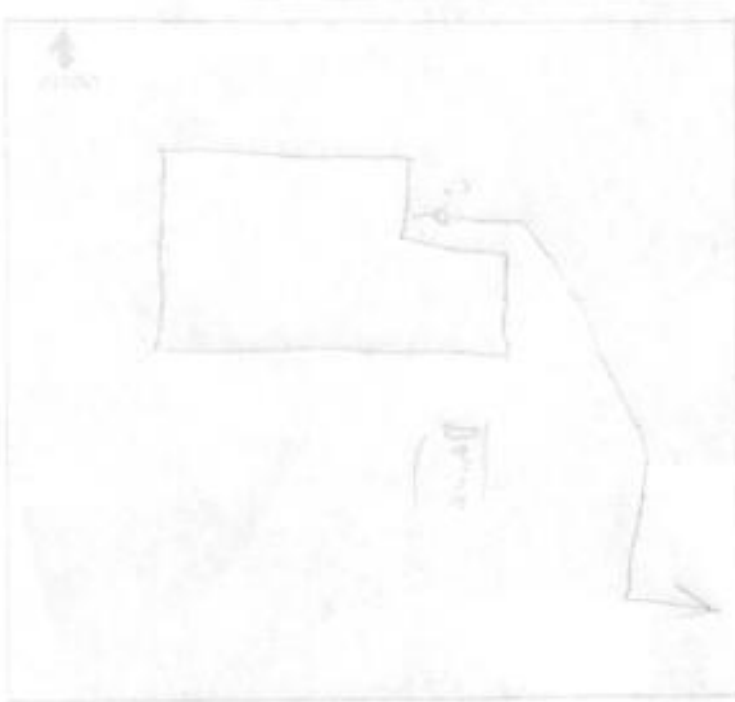

9378 S. CR 650 W.
P.O. Box 59
Pendleton, IN 46064
Phone: 765-778-7544

INVOICE

Customer		Project Area # D	
Name	Scott Stump	Acct #	
Address	6267 Senate Court		W.O. # 9915
City	Pendleton	State IN	Due Date 90 days
Phone		Zip 46064	

DATE	PAYMENT	CHECK NUMBER	AMOUNT
		Sub-Total	\$0.00

Cut here

Customer					
Name	Scott Stump	Acct #		Project Area #	D
Address	6267 Senate Court			W.O. #	9915
City	Pendleton	State	IN	Zip	46064
Phone					0
				Amount Due	\$2,556.00