

# FALL CREEK REGIONAL WASTE DISTRICT

9378 S 650 WEST, P.O. BOX 59, PENDLETON, IN 46064

765-778-7544

## AGREEMENT FOR SANITARY SEWER SERVICE

This Agreement made and entered into this 18<sup>th</sup> day of November, 2004, between FALL CREEK REGIONAL WASTE DISTRICT ("District") and Marc & Amy Bailey ("Applicant") regarding the provision of sanitary sewer service, and the assignment of capacity in, and connection to, the District's facilities for the premises located at Foster Branch Woods, lot 14

**NOW THEREFORE**, the parties, in consideration of the mutual promises set out in this Agreement, the receipt and sufficiency of which is hereby acknowledged, agree as follows:

1. The Applicant agrees that all workmanship and materials shall conform to all District ordinances and the District's construction standards. District must accept and approve all work and materials before backfilling and final connection is made to the sewer mains. Any violation of this provision will cause all lines and appurtenances in violation to be removed and replaced at the Applicant's expense.
2. The District shall have the right to enter upon the Applicant's premises at all reasonable times to inspect, repair, or replace any equipment used in connection with the District's service or which has an impact on said service.
3. The Applicant shall be responsible for all monthly user rates, capacity charges, and tap fees. The failure to pay any rate charge or fee may result in a lien against the property and/or the termination of service to the property, the cost of which will be borne by Applicant, including, but not limited to, all attorney's fees and collection costs.
4. The District shall not be responsible for any damages as a result of any failure to supply service unless said damages are due to default, neglect or culpability on the part of the District.
5. If there is an available sanitary sewer within three hundred (300) feet of the property line, the property owner shall be required to connect to the District's sanitary sewer system.
6. The Applicant and District agree that the provision of sanitary sewer service touches and concerns the property and the terms of this Agreement bind the District and Applicant and their heirs, executors, administrators, personal representatives, successors, agents, attorneys, assigns, designees, and transferees.

The parties hereto have read and fully understand the above provisions and agree to comply with said provisions.

FALL CREEK REGIONAL WASTE DISTRICT  
Deborah L. Wilson  
Signature

APPLICANT  
Ch. A. Bailey  
Signature

STATE OF INDIANA )  
 ) SS:  
COUNTY OF MADISON )

SUBSCRIBED and sworn to before me this 18<sup>th</sup> day of November, 2004.

My Commission Expires:  
2-20-2008

Signature Deborah L. Wilson  
Printed Deborah L. Wilson

Notary Public  
Resident of Madison County

\*\*\*\*\*  
INSPECTOR Don DATE INSPECTED 8/15/05 APPROVED ✓ REJECTED \_\_\_\_\_

REASON FOR REJECTION \_\_\_\_\_

DATE REINSPECTED \_\_\_\_\_ APPROVED \_\_\_\_\_ REJECTED \_\_\_\_\_

NOTES: SIZE PIPE 4" / 1 1/2 TYPE PIPE 4" / 160 psi

BASEMENT YES \_\_\_\_\_ NO ✓

SUMP PUMP YES \_\_\_\_\_ NO ✓

DOWNSPOUT TO GROUND YES \_\_\_\_\_ NO ✓


SEPTIC TANK PUMPED & FILLED YES \_\_\_\_\_ NO NA

CONTRACTOR DAN FESLER

SPECIAL CONDITIONS \_\_\_\_\_

EXISTING HOME \_\_\_\_\_

NEW CONSTRUCTION ✓

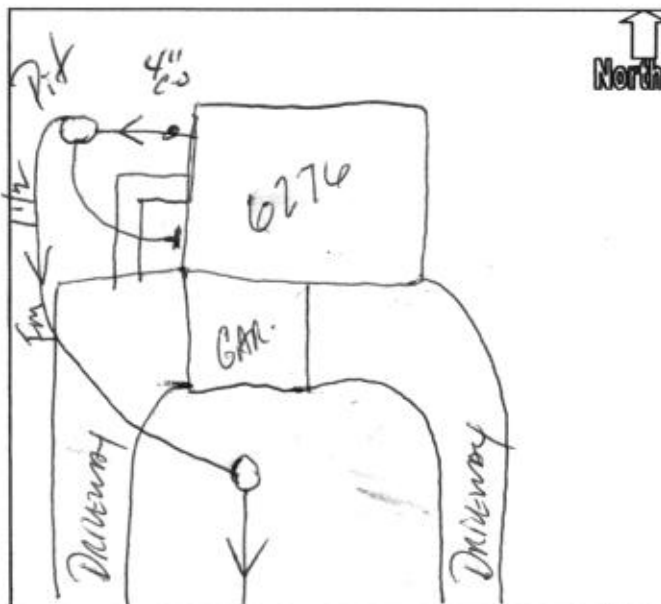



CSCM LLC  
CUSTOM HOMES BY COLE  
3925 RIVER CROSSING PKWY STE. 150  
INDIANAPOLIS, IN 46240

1195

71-859/749

DATE 11/18/2004

PAY TO THE ORDER OF Fall Creek Regional Waste \$ 2635.00

Two thousand six hundred thirty-five & 00/100 DOLLARS

 Fifth Third Bank  
INDIANA (CENTRAL)  
INDIANAPOLIS, INDIANA

FOR \_\_\_\_\_

Cheryl A. Suber MP

⑈001195⑈ ⑆074908594⑆ 7651765948⑈

**Signature Plumbing Co., INC.**

P.O. Box 69  
Markleville, IN 46056  
765-533-2287

**Madison Community Bank**  
State Rd 38 & Cr 300 E  
Markleville, IN 46056  
765-533-4333

**3129**

Date 7/25/2005

71-553 / 7498946310

Pay to the

Order of

Fall Creek Regional waste District

\$ \*\*1,549.72

One Thousand Five Hundred Forty-Nine and 72/100\*\*\*\*\* Dollars

Fall Creek Regional waste District  
P.O. Box 59  
Pendleton, IN 46064

Memo

*Desira Tesler*

⑆074905539⑆ 894 6310 3129