

#6587

This Agreement made and entered into this 14 day of September, 2016, between Fall Creek Regional Waste District ("District") and Ed Hiddle ("Applicant") regarding the provision of sanitary sewer service, and the assignment of capacity in and connection to, the District's facilities for the premises located at 627 Falls Park Drive, Pendleton.

1. The Applicant agrees that all workmanship and materials shall conform to all District ordinances and the District's construction standards. District must accept and approve all work and materials before backfilling and final connection is made to the sewer mains. Any violation of this provision will cause all lines and appurtenances in violation to be removed and replaced at the Applicant's expense.
2. The District shall have the right to enter upon the Applicant's premises at all reasonable times to inspect, repair, or replace any equipment used in connection with the District's service or which has an impact on said service.
3. The Applicant shall be responsible for all monthly user rates, capacity charges, and tap fees. The failure to pay any rate charge or fee may result in a lien against the property and/or the termination of service to the property, the cost of which will be borne by Applicant, including, but not limited to, all attorney's fees and collection costs.
4. The District shall not be responsible for any damages as a result of any failure to supply service unless said damages are due to default, neglect or culpability on the part of the District.
5. If there is an available sanitary sewer within three hundred (300) feet of the property line, the property owner shall be required to connect to the District's sanitary sewer system.
6. The Applicant and District agree that the provision of sanitary sewer service touches and concerns the property and the terms of this Agreement bind the District and Applicant and their heirs, executors, administrators, personal representatives, successors, agents, attorneys, assigns, designees, and transferees.

APPLICANT  
Signature

SUBSCRIBED and sworn to before me this 14<sup>th</sup> day of September, 2016

Official Seal: OFFICIAL SEAL  
TERESA K. HUTTON  
NOTARY PUBLIC - STATE OF INDIANA  
MADISON COUNTY  
MY COMM. EXPIRES APRIL 12, 2004

Signature Jessica K Hutton

Printed Teresa K Hutton

Notary Public  
Resident of Madison County

\*\*\*\*\* Resident of Madison County \*\*\*\*\*

Inspector Tim Date Inspected 6-29-17 Approved ✓ Rejected       

Reason for Rejection \_\_\_\_\_

Date Reinspected \_\_\_\_\_ Approved \_\_\_\_\_ Rejected \_\_\_\_\_

Size Pipe 4' 35 Type Pipe 1 1/2 class 160

Basement Yes No ☒

Sump Pump Yes ☐ No ☒

Downspout to Ground Yes ☒ No ☐


Septic Tank Pumped & Filled Yes No

Contractor BL Brown.

Special Conditions

Existing Home \_\_\_\_\_

**New Construction** ✓

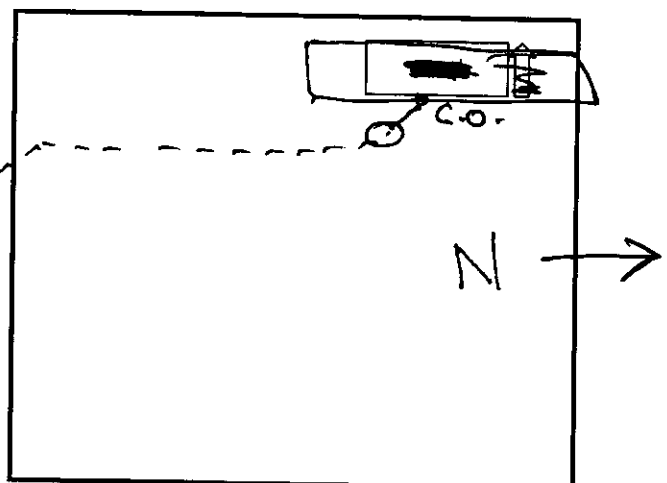

Ed Hubble

607 Falls Park Dr

Tim McElroy  
6-29-17





JAY EDWIN HUBBLE  
DAWN D HUBBLE  
PH. 765-778-1115  
1114 PENDLE HILL AVE  
PENDLETON, IN 46064

71-65/749

2459

DATE 9-14-16 PHP

© 2016 FIRST MERCHANTS BANK  
SPECIALTY FILM HIGH SECURITY



PAY TO  
THE ORDER OF

FCRWD

SEVEN Hundred & ten

\$ 710.00

00 DOLLARS

Heat  
Reactive  
Ink



First Merchants Bank  
www.firstmerchants.com

MEMO

*Jay E Hubble*  
11.59

MP

LOOK FOR FRAUD-DETECTING FEATURES INCLUDING THE SECURITY SQUARE AND HEAT-REACTIVE INK. DETAILS ON BACK.