


Gidw.

PROJECT Phase II SHEET _____ OF _____
SUBJECT _____ DATE 6-13-18
JOB NO. 4447
BY At/As

628 S. Center

N →

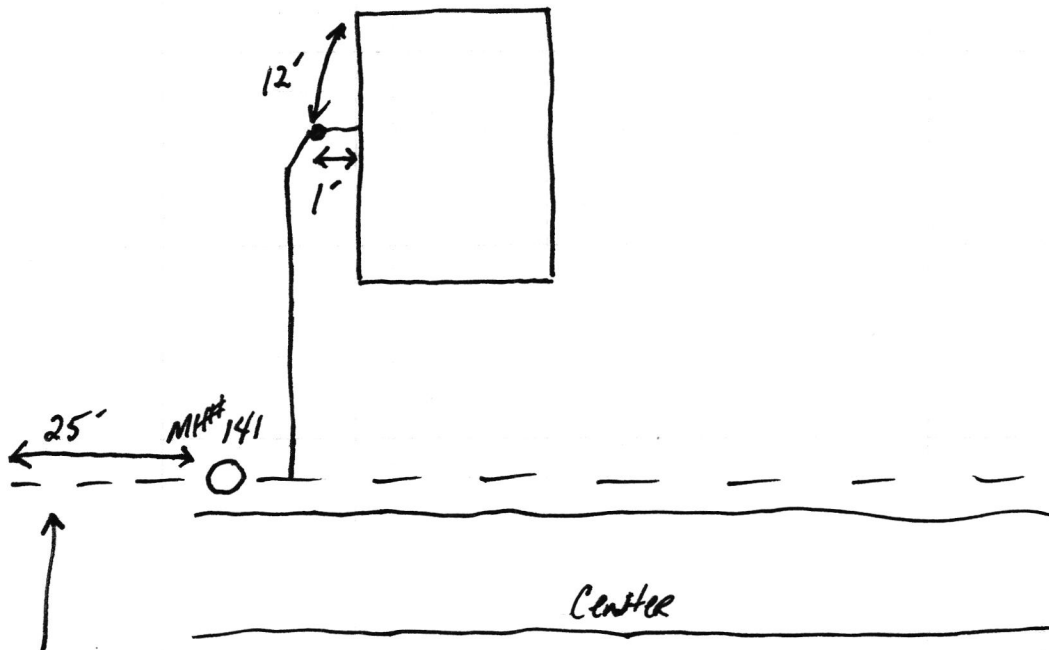

8" main deadends w/ 644 S. Center tied into the end of it.

Gas Center

Srf Phase II

6.19.18

