

Gidw.


PROJECT Phase II SHEET _____ OF _____

SUBJECT _____ DATE 5-1-18

JOB NO. 4447

BY Atlas

~~623~~ S. BROADWAY
628

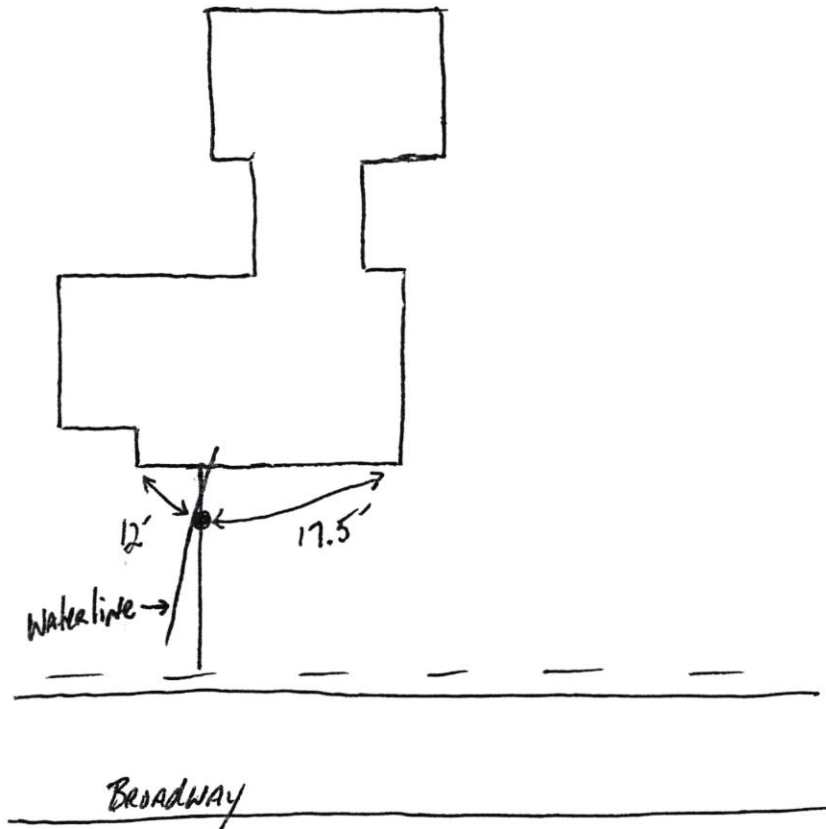

628 S Broadway

SRF
Phase II

5.3.18

