


Gidw.

PROJECT Phase II SHEET _____ OF _____
SUBJECT _____ DATE 6-14-18
JOB NO. 4447
BY Atlas

629 S. Center

← N

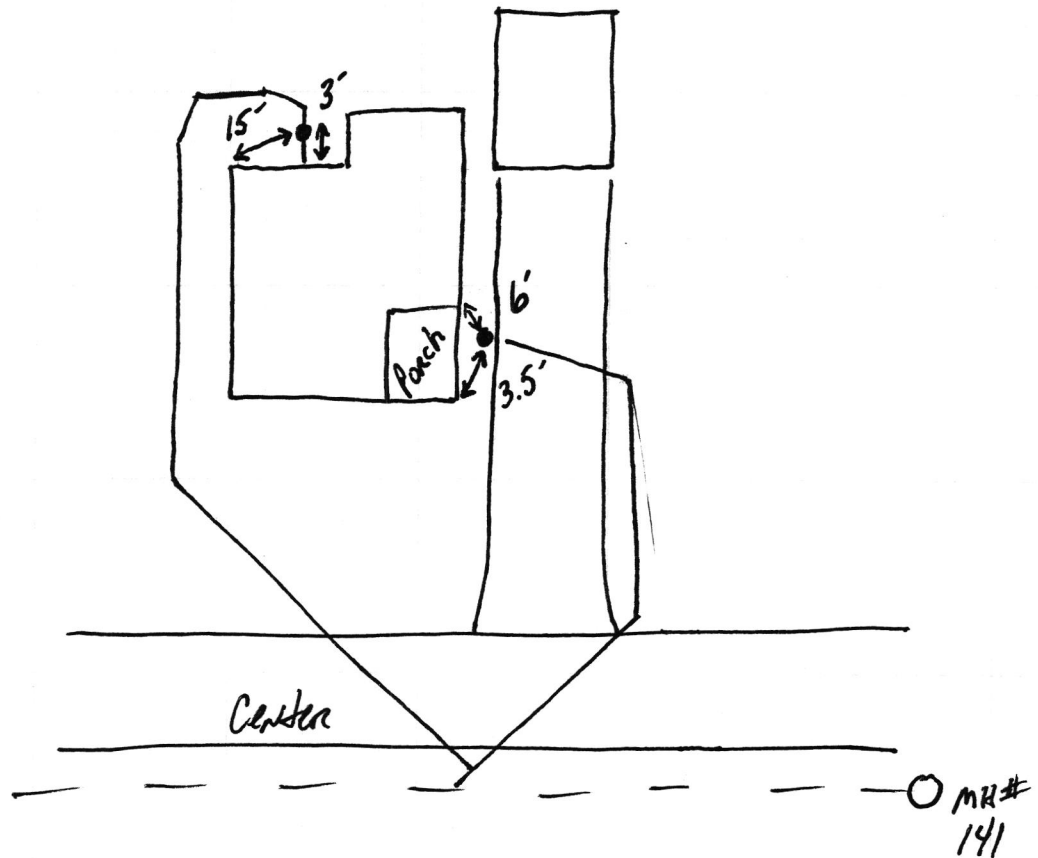

Wash Center

SRE Phase II

6.19.18



UAG Carter

SRF Phase II

6.19.18

