



FALL CREEK REGIONAL WASTE DISTRICT

9378 S. 650 West PO Box 59
Pendleton, IN 46064-0059 778-7544

26-09110.00

add order
on file

APPLICATION FOR SEWER PERMIT

Nº 2775

Date May 10, 2000

Permit Void 90 days from Date of Issuance

Owner Name TOYZANNE & CHRISTOPHER MASON

Property Address 6305 S SUPREME COURT

Lot # 25

P.O. Box _____

Town PENDLETON

, IN Zip Code 46064

Phone (765) 778-8922

City Water _____

Well ☒

\$ 2156

Tap on Fee Paid

\$ 400

Inspection fee paid

Gerry Fredericks
-contractor

Application is hereby made for connection to the Fall Creek Regional Waste District Sewer System for the above listed property - Permit Type: Residential ☒, Commercial _____, Industrial _____, or Governmental/Institutional _____. User Information _____.

All workmanship and materials shall conform to the standards of the District Ordinance as described in Ordinance 84-2 and 84-3 as amended. Acceptance and approval must be made by the District inspector or his duly authorized representative before backfilling and final connection is made to the main sewer lines. Any violation of applicable regulations will cause all lines and appurtenances in violation to be removed and replaced at the owners expense.

The Fall Creek Regional Waste District is responsible for the inspection, approval of materials, and installation techniques only. All costs for materials and installation and any liabilities resulting from same is the sole responsibility of the property owner.

I have read and fully understand the above provisions and agree to comply by said provisions.

Joyanne Mason

APPLICANT(S) SIGNATURE

INSPECTOR B

Date inspected 5-24-00

Approved ☒

Rejected _____

Reason for rejection _____

Date reinspected _____

Approved _____

Rejected _____

Notes:

Size Pipe 6"

Type Pipe PVC

Basement Yes ☒ No _____

Sump Pump Yes ☒ No _____

Downspout to Ground Yes ☒ No _____


Septic Tank Pumped & filled Yes ☒ No _____

Contractor Gerry Fredericks

Special Conditions _____

Existing Home ☒

New Construction _____

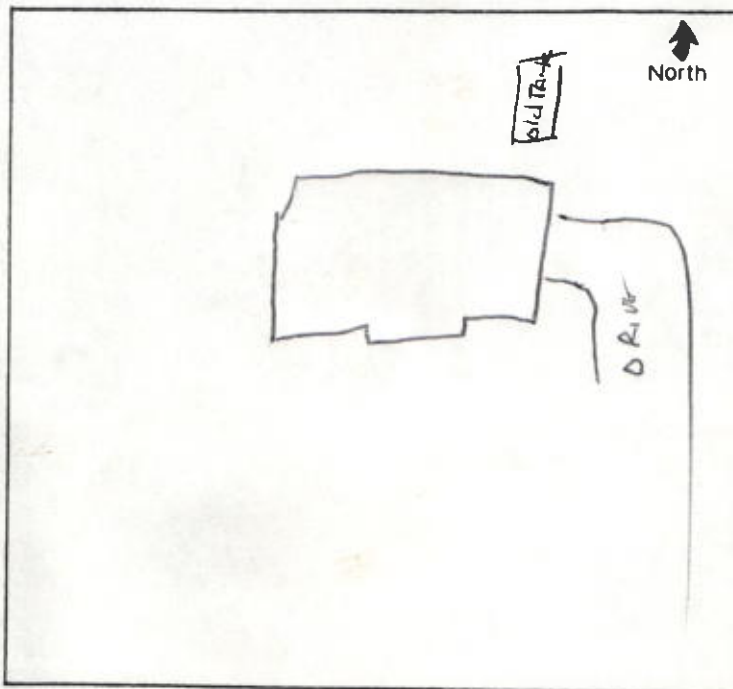

FALL CREEK REGIONAL WASTE DISTRICT

3175 S. 625 West PO Box 25
Tulsa, OK 74106-0025 758-7314



NO 2772

APPLICATION FOR STATE PERMIT

DATE May 10, 2000

Project Name: Topsoil & Gravel Storage
 Project Location: Box 2, Superior, OK
 Applicant: Thompson
 Phone: (918) 716-8143
 Fax: 716-8143

Thompson
Contractor

Project Description: Storage of topsoil and gravel for the area around the project site.
 Project Location: Box 2, Superior, OK
 Project Size: 10,000 sq. ft.

All activities shall be conducted in accordance with the standards of the Oklahoma Department of Environmental Quality (ODEQ) and the Oklahoma Department of Transportation (ODOT). The project shall be designed to prevent any erosion or sedimentation from the project site. The project shall be designed to prevent any pollution of the project site. The project shall be designed to prevent any damage to the project site.


The project shall be designed to prevent any damage to the project site. The project shall be designed to prevent any pollution of the project site. The project shall be designed to prevent any erosion or sedimentation from the project site. The project shall be designed to prevent any damage to the project site.

The project shall be designed to prevent any damage to the project site. The project shall be designed to prevent any pollution of the project site. The project shall be designed to prevent any erosion or sedimentation from the project site. The project shall be designed to prevent any damage to the project site.

Signature

Signature

2-25-00

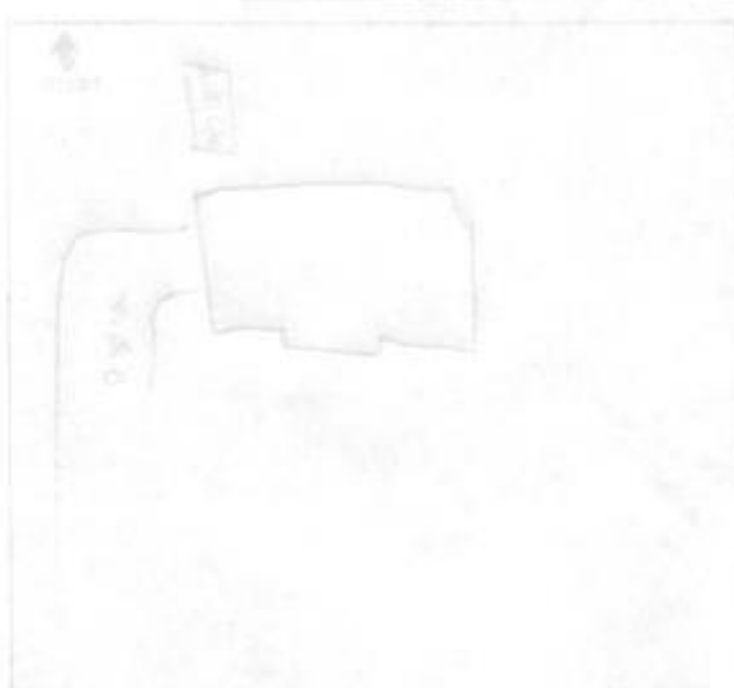

Project Name: Topsoil & Gravel Storage
 Project Location: Box 2, Superior, OK
 Project Size: 10,000 sq. ft.
 Project Description: Storage of topsoil and gravel for the area around the project site.

9378 S. CR 650 W.
P.O. Box 59
Pendleton, IN 46064
Phone: 765-778-7544

INVOICE

Name Christopher Mason Acct # _____
Address 6305 S Supreme Court
City Pendleton State IN Zip 46064
Phone _____

Project Area # D
W.O. # 9915
Due Date 90 days

QTY	DESCRIPTION	UNIT PRICE	TOTAL
1	tap fee	\$400.00	\$400.00
1	capacity fee	\$2,156.00	\$2,156.00
		Sub-Total	\$2,556.00

DATE	PAYMENT	CHECK NUMBER	AMOUNT
		Sub-Total	\$0.00

TOTAL	\$2,556.00
--------------	-------------------

Detach bottom portion and return with payment

Cut here

Name Christopher Mason Acct # _____
Address 6305 S Supreme Court
City Pendleton State IN Zip 46064
Phone _____

Project Area #	D
W.O. #	9915
Due Date	90 days

Amount Due	\$2,556.00
------------	------------