

26-09160-00

Fall Creek Regional Waste District
9378 S 650 W, P.O. Box 59, Pendleton, IN 46064
765-778-7544

#6460

Agreement for Sanitary Sewer Service

This Agreement made and entered into this 15 day of April, 2013, between Fall Creek Regional Waste District ("District") and George Edwards ("Applicant") regarding the provision of sanitary sewer service, and the assignment of capacity in and connection to, the District's facilities for the premises located at Jefferson Place Lot 30.

6300 Supreme CT

Now therefore, the parties, in consideration of the mutual promises set out in this Agreement, the receipt and sufficiency of which is hereby acknowledged, agree as follows:

1. The Applicant agrees that all workmanship and materials shall conform to all District ordinances and the District's construction standards. District must accept and approve all work and materials before backfilling and final connection is made to the sewer mains. Any violation of this provision will cause all lines and appurtenances in violation to be removed and replaced at the Applicant's expense.
2. The District shall have the right to enter upon the Applicant's premises at all reasonable times to inspect, repair, or replace any equipment used in connection with the District's service or which has an impact on said service.
3. The Applicant shall be responsible for all monthly user rates, capacity charges, and tap fees. The failure to pay any rate charge or fee may result in a lien against the property and/or the termination of service to the property, the cost of which will be borne by Applicant, including, but not limited to, all attorney's fees and collection costs.
4. The District shall not be responsible for any damages as a result of any failure to supply service unless said damages are due to default, neglect or culpability on the part of the District.
5. If there is an available sanitary sewer within three hundred (300) feet of the property line, the property owner shall be required to connect to the District's sanitary sewer system.
6. The Applicant and District agree that the provision of sanitary sewer service touches and concerns the property and the terms of this Agreement bind the District and Applicant and their heirs, executors, administrators, personal representatives, successors, agents, attorneys, assigns, designees, and transferees.

The parties hereto have read and fully understand the above provisions and agree to comply with said provisions.

FALL CREEK REGIONAL WASTE DISTRICT
Rebecca Hunter
Signature

APPLICANT
George Edwards
Signature

STATE OF INDIANA)
) SS:
COUNTY OF MADISON)

SUBSCRIBED and sworn to before me this 15 day of April, 2013

My Commission Expires:




Commission Expires November 20, 2015
A Resident of
Hamilton County, Indiana
Rebecca Lynn Hunter, Notary Public

Signature Rebecca Lynn Hunter
Printed Rebecca Lynn Hunter
Notary Public
Resident of Hamilton County

Inspector JT Date Inspected 8-27-13 Approved ✓ Rejected _____
Reason for Rejection _____
Date Reinspected _____ Approved _____ Rejected _____

Notes:

Size Pipe 6' Type Pipe SDR35
Basement Yes No
Sump Pump Yes No
Downspout to Ground Yes No
Septic Tank Pumped & Filled Yes No
Contractor Chandler
Special Conditions _____
Existing Home _____
New Construction ✓

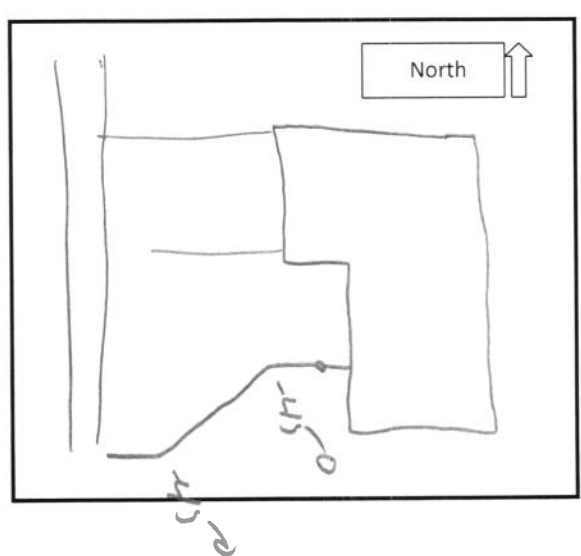



Committee on the Status of the
Children
U. S. Department of the Interior
Bureau of Indian Affairs
Washington, D. C.

FALL CREEK REGIONAL WASTE DISTRI
9378 S 650 W
PO BOX 59
PENDLETON, IN 46064
765-778-7544

FALL CREEK REGIONAL WASTE DIST
0005560008022120839000

Date: 04/15/2013 03:25:29 PM

CREDIT CARD SALE
R-E-P-R-I-N-T

CARD NUMBER: *****7990 K
TRAN AMOUNT: \$570.00
APPROVAL CD: 02555Z
ECI:
RECORD #: 000
CLERK ID: Becca
INVOICE #: JP Tap Fee

Copy
only

X

Karina Edwards

I AGREE TO PAY THE ABOVE TOTAL AMOUNT
ACCORDING TO THE CARD ISSUER AGREEMENT
(MERCHANT AGREEMENT IF CREDIT VOUCHER)

Thank you for your business!

Merchant Copy