



FALL CREEK REGIONAL WASTE DISTRICT

9378 S. 650 West PO Box 59
Pendleton, IN 46064-0059 778-7544

add order
on file

22-27570.00

Contractor: David Ford Construction

APPLICATION FOR SEWER PERMIT

No 2721

Date 12/13/99

Permit Void 90 days from Date of Issuance

Owner Name

Property Address

Lot #

Town

Phone

P.O. Box

IN Zip Code

City Water

Well

\$

Tap on Fee Paid

\$

Inspection fee paid

Application is hereby made for connection to the Fall Creek Regional Waste District Sewer System for the above listed property - Permit Type: Residential ☒, Commercial ☐, Industrial ☐, or Governmental/Institutional ☐. User Information

All workmanship and materials shall conform to the standards of the District Ordinance as described in Ordinance 84-2 and 84-3 as amended. Acceptance and approval must be made by the District inspector or his duly authorized representative before backfilling and final connection is made to the main sewer lines. Any violation of applicable regulations will cause all lines and appurtenances in violation to be removed and replaced at the owners expense.

The Fall Creek Regional Waste District is responsible for the inspection, approval of materials, and installation techniques only. All costs for materials and installation and any liabilities resulting from same is the sole responsibility of the property owner.

I have read and fully understand the above provisions and agree to comply by said provisions.

APPLICANT(S) SIGNATURE

INSPECTOR

Date inspected 12-13-99

Approved

Rejected

Reason for rejection

Date reinspected

Approved

Rejected

Notes:

Size Pipe

Type Pipe

Basement Yes

No

Sump Pump Yes

No

Downspout to Ground Yes

No

Septic Tank Pumped & filled Yes


No

Contractor

Special Conditions

Existing Home

New Construction

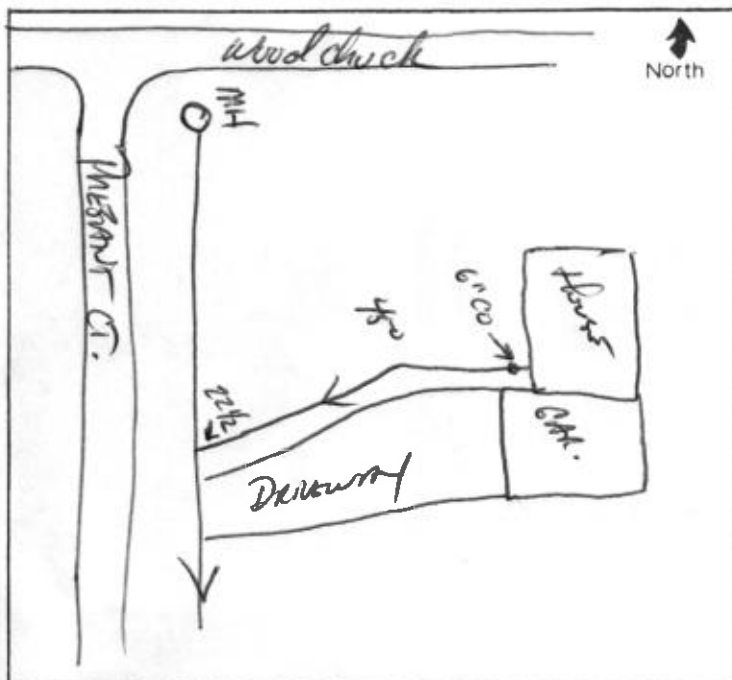



GERRY OR DIANE FREDERICKS 12-77
4424 E 575 S PH 779-4269
MARKLEVILLE, IN 46056

7414

DATE 12/13/99

71-553/749
BRANCH 1

PAY TO THE
ORDER OF

Fall Creek Regional Waste
from hundred dollars and no cents

\$ 400



Madison
Community Bank

DOLLARS  Security features
included.
Details on back.

FOR

lot 136

Dan Fredrick

MP

⑆074905539⑆ 236 394 8⑈ 7414

© HARLAND