



FALL CREEK REGIONAL WASTE DISTRICT

9378 S. 650 West PO Box 59  
Pendleton, IN 46064-0059 778-7544

add order  
on file

8-18564.01

APPLICATION FOR SEWER PERMIT

Nº 2196

Date 5/5/95

Permit Void 90 days from Date of Issuance

Owner Name Gary Riddle

Property Address 630 N Pendleton Ave.

Lot # \_\_\_\_\_ P.O. Box \_\_\_\_\_

Town Pendleton, IN Zip Code 46064

Phone \_\_\_\_\_ City Water \_\_\_\_\_ Well \_\_\_\_\_

\$ 2700.00 Tap on Fee Paid

\$ 25.00 Inspection fee paid

Application is hereby made for connection to the Fall Creek Regional Waste District Sewer System for the above listed property - Permit Type: Residential ☒, Commercial \_\_\_\_\_, Industrial \_\_\_\_\_, or Governmental/Institutional \_\_\_\_\_. User Information \_\_\_\_\_.

All workmanship and materials shall conform to the standards of the District Ordinance as described in Ordinance 84-2 and 84-3 as amended. Acceptance and approval must be made by the District inspector or his duly authorized representative before backfilling and final connection is made to the main sewer lines. Any violation of applicable regulations will cause all lines and appurtenances in violation to be removed and replaced at the owners expense.

The Fall Creek Regional Waste District is responsible for the inspection, approval of materials, and installation techniques only. All costs for materials and installation and any liabilities resulting from same is the sole responsibility of the property owner.

I have read and fully understand the above provisions and agree to comply by said provisions.

APPLICANT(S) SIGNATURE

\*\*\*\*\*

INSPECTOR B

Date inspected 5-5-95 Approved ☒ Rejected \_\_\_\_\_

Reason for rejection \_\_\_\_\_

Date reinspected \_\_\_\_\_ Approved \_\_\_\_\_ Rejected \_\_\_\_\_

Notes:

Size Pipe 6 "

Type Pipe PVC

Basement Yes ☒ No \_\_\_\_\_

Sump Pump Yes \_\_\_\_\_ No ☒

Downspout to Ground Yes \_\_\_\_\_ No \_\_\_\_\_


Septic Tank Pumped & filled Yes ☒ No \_\_\_\_\_

Contractor EARL DAVIS

Special Conditions \_\_\_\_\_

Existing Home ☒

New Construction \_\_\_\_\_

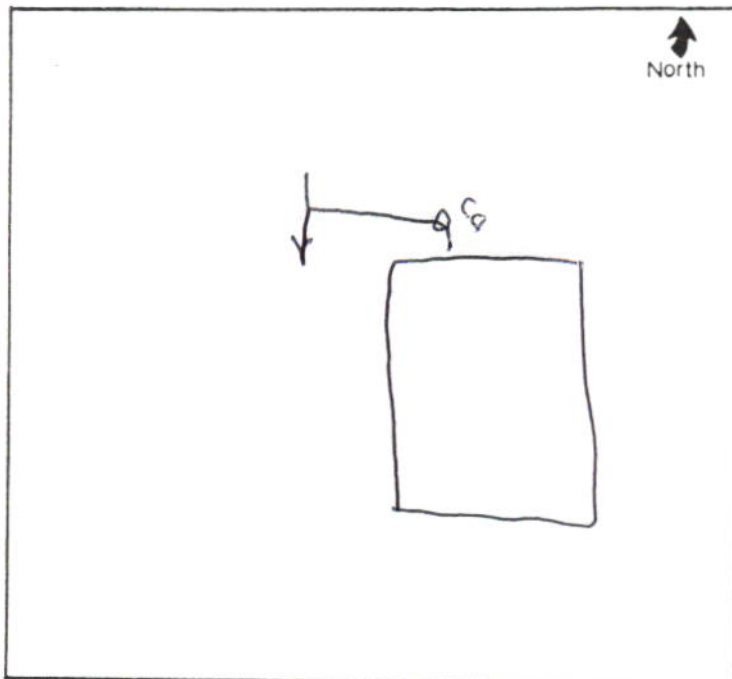



# FALL CREEK REGIONAL WASTE DISTRICT

9378 S. 650 West PO Box 59  
Pendleton, IN 46064-0059 778-7544

8-18564.04

## APPLICATION FOR SEWER PERMIT

Nº 2728

Date

2/4/00

Permit Void 90 days from Date of Issuance

Owner Name

Becky Bray

Property Address

630 N Pendleton Ave

Lot #

P.O. Box

Town

Pendleton

IN

Zip Code

46064

Phone

City Water

Well

\$

N/A

Tap on Fee Paid

\$

N/A

Inspection fee paid

re-connection  
\$100 pd 5/10/00

Application is hereby made for connection to the Fall Creek Regional Waste District Sewer System for the above listed property - Permit Type: Residential ☒, Commercial ☐, Industrial ☐, or Governmental/Institutional ☐. User Information

All workmanship and materials shall conform to the standards of the District Ordinance as described in Ordinance 84-2 and 84-3 as amended. Acceptance and approval must be made by the District inspector or his duly authorized representative before backfilling and final connection is made to the main sewer lines. Any violation of applicable regulations will cause all lines and appurtenances in violation to be removed and replaced at the owners expense.

The Fall Creek Regional Waste District is responsible for the inspection, approval of materials, and installation techniques only. All costs for materials and installation and any liabilities resulting from same is the sole responsibility of the property owner.

I have read and fully understand the above provisions and agree to comply by said provisions.

APPLICANT(S) SIGNATURE

\*\*\*\*\*

INSPECTOR

Ba

Date inspected

2-4-00

Approved

☒

Rejected

Reason for rejection

Date reinspected

Approved

Rejected

Notes:

Size Pipe

6"

"

Type Pipe

PVC

Basement Yes

No ☒

Sump Pump Yes

No ☒

Downspout to Ground Yes ☒ No

Septic Tank Pumped & filled Yes

No ☒

Contractor

Ted Brown/G Davis


Special Conditions

Reconnect


Existing Home

☒

New Construction

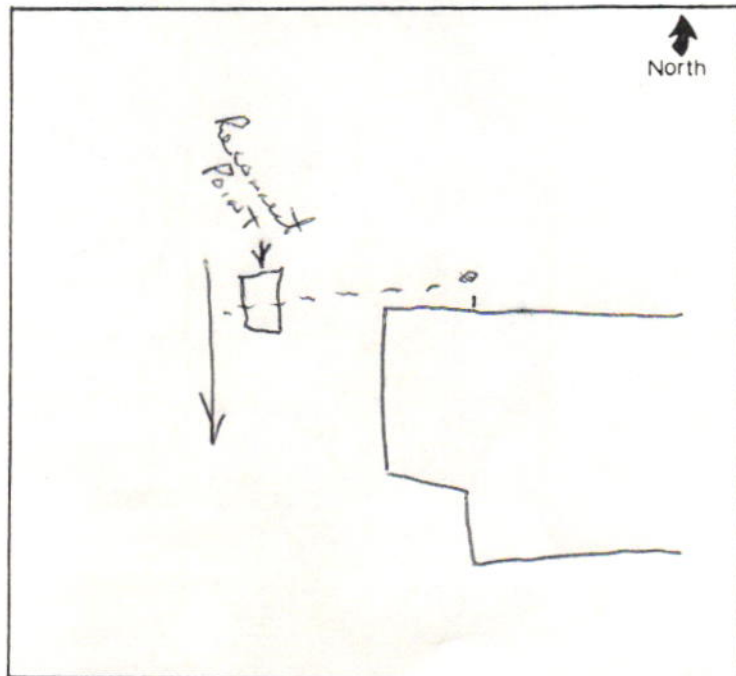

## HOME BUYERS OF INDIANA INC.

83 LINCOLN HILLS DRIVE  
COATESVILLE, IN 46121DATE 5-1-0820-104/740  
922PAY  
TO THE  
ORDER OFFALL. COCK. REG. WASTE DIS \$ 162.09One hundred & Sixty Two ~~off~~ DOLLARS  Security features  
are included.  
Details on back.KeyBank National Association  
Greenwood, Indiana 46142  
1-800-KEY2YOU

FOR

Becky Brany MP

⑈000597⑈ ⑆074001048⑆