

FALL CREEK REGIONAL WASTE DISTRICT

9378 S 650 WEST, P.O. BOX 59, PENDLETON, IN 46064

765-778-7544

AGREEMENT FOR SANITARY SEWER SERVICE

This Agreement made and entered into this 17 day of September, 2004, between FALL CREEK REGIONAL WASTE DISTRICT ("District") and Mary Parker ("Applicant") regarding the provision of sanitary sewer service, and the assignment of capacity in, and connection to, the District's facilities for the premises located at 630 Silver Street, Pendleton.

NOW THEREFORE, the parties, in consideration of the mutual promises set out in this Agreement, the receipt and sufficiency of which is hereby acknowledged, agree as follows:

1. The Applicant agrees that all workmanship and materials shall conform to all District ordinances and the District's construction standards. District must accept and approve all work and materials before backfilling and final connection is made to the sewer mains. Any violation of this provision will cause all lines and appurtenances in violation to be removed and replaced at the Applicant's expense.
2. The District shall have the right to enter upon the Applicant's premises at all reasonable times to inspect, repair, or replace any equipment used in connection with the District's service or which has an impact on said service.
3. The Applicant shall be responsible for all monthly user rates, capacity charges, and tap fees. The failure to pay any rate charge or fee may result in a lien against the property and/or the termination of service to the property, the cost of which will be borne by Applicant, including, but not limited to, all attorney's fees and collection costs.
4. The District shall not be responsible for any damages as a result of any failure to supply service unless said damages are due to default, neglect or culpability on the part of the District.
5. If there is an available sanitary sewer within three hundred (300) feet of the property line, the property owner shall be required to connect to the District's sanitary sewer system.
6. The Applicant and District agree that the provision of sanitary sewer service touches and concerns the property and the terms of this Agreement bind the District and Applicant and their heirs, executors, administrators, personal representatives, successors, agents, attorneys, assigns, designees, and transferees.

The parties hereto have read and fully understand the above provisions and agree to comply with said provisions.

FALL CREEK REGIONAL WASTE DISTRICT

Signature

APPLICANT

Signature

STATE OF INDIANA)
) SS:
COUNTY OF MADISON)

SUBSCRIBED and sworn to before me this 17 day of September, 2004

My Commission Expires:

2-20-2008

Signature _____

Printed

Notary Public
Resident of Madison County

INSPECTOR TK DATE INSPECTED 9/16/04 APPROVED ☒ REJECTED

REASON FOR REJECTION

DATE REINSPECTED _____ APPROVED _____ REJECTED _____

NOTES:

SIZE PIPE

TYPE PIPE

BASEMENT YES

NO

SUMP PUMP YES

NO

DOWNSPOUT TO GROUND YES

NO

SEPTIC TANK PUMPED & FILLED YES


NO

CONTRACTOR *DICK GODBY*

SPECIAL CONDITIONS

EXISTING HOME

NEW CONSTRUCTION

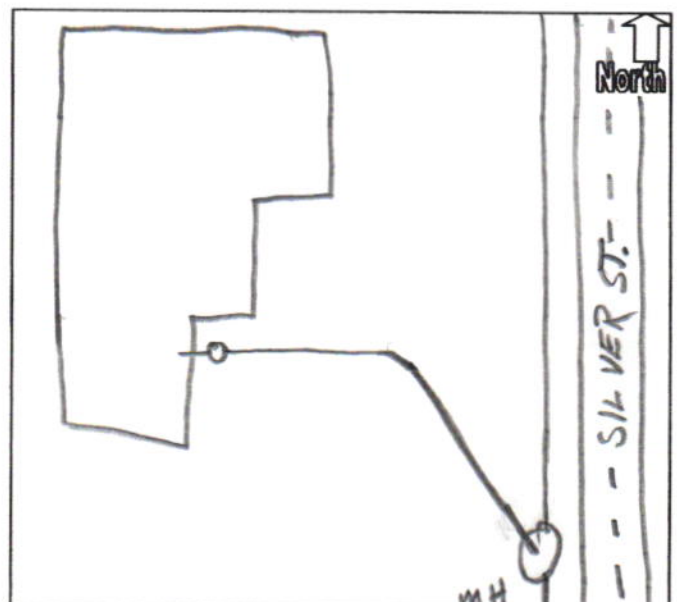

MARY J. PARKER
200 W. OLD STATE RD. 132
PENDLETON, IN 46064

71-553/749
1915711

1001

DATE 9-17-04

© DELUXE WALLET OR DUPLICATE

PAY TO
THE ORDER OF

Frank Park Regional Water District \$ 2635.00

Twenty-six hundred & thirty-five - 00/100 DOLLARS



Security Features
included.
Details on back.



Madison
Community Bank



MEMO

Sewer Hook up

Mary J. Parker

MP

⑆074905539⑆

100

SPECIALTY GRAY