



FALL CREEK REGIONAL WASTE DISTRICT

9378 S. 650 West PO Box 59  
Pendleton, IN 46064-0059 778-7544

26-08170.00

765-847-5605

add order  
on file

APPLICATION FOR SEWER PERMIT

Nº 2881

Date 9-12-00

Permit Void 90 days from Date of Issuance

Owner Name Mark Mennon - Riffey Blars.

Property Address 6315 W. Fosters Branch

Lot # 18 P.O. Box \_\_\_\_\_

Town Pendleton, IN Zip Code 46064

Phone \_\_\_\_\_ City Water \_\_\_\_\_ Well ☒

\$ 2556.00 Tap on Fee Paid

\$ \_\_\_\_\_ Inspection fee paid

grinder unit paid for by  
Long & Koefers

Application is hereby made for connection to the Fall Creek Regional Waste District Sewer System for the above listed property - Permit Type: Residential ☒, Commercial \_\_\_\_\_, Industrial \_\_\_\_\_, or Governmental/Institutional \_\_\_\_\_. User Information \_\_\_\_\_.

All workmanship and materials shall conform to the standards of the District Ordinance as described in Ordinance 84-2 and 84-3 as amended. Acceptance and approval must be made by the District inspector or his duly authorized representative before backfilling and final connection is made to the main sewer lines. Any violation of applicable regulations will cause all lines and appurtenances in violation to be removed and replaced at the owners expense.

The Fall Creek Regional Waste District is responsible for the inspection, approval of materials, and installation techniques only. All costs for materials and installation and any liabilities resulting from same is the sole responsibility of the property owner.

I have read and fully understand the above provisions and agree to comply by said provisions.

Robert Riffey  
APPLICANT(S) SIGNATURE

\*\*\*\*\*

INSPECTOR TIM

Date inspected 9-14- Approved ☒ Rejected \_\_\_\_\_

Reason for rejection \_\_\_\_\_

Date reinspected \_\_\_\_\_ Approved \_\_\_\_\_ Rejected \_\_\_\_\_

Notes:

Size Pipe 4"

Type Pipe SDR 35

Basement Yes ☒ No ☒

Sump Pump Yes ☒ No ☒

Downspout to Ground Yes ☒ No \_\_\_\_\_


Septic Tank Pumped & filled Yes ☒ No \_\_\_\_\_

Contractor Long & Koefers

Special Conditions \_\_\_\_\_

Existing Home \_\_\_\_\_

New Construction ☒

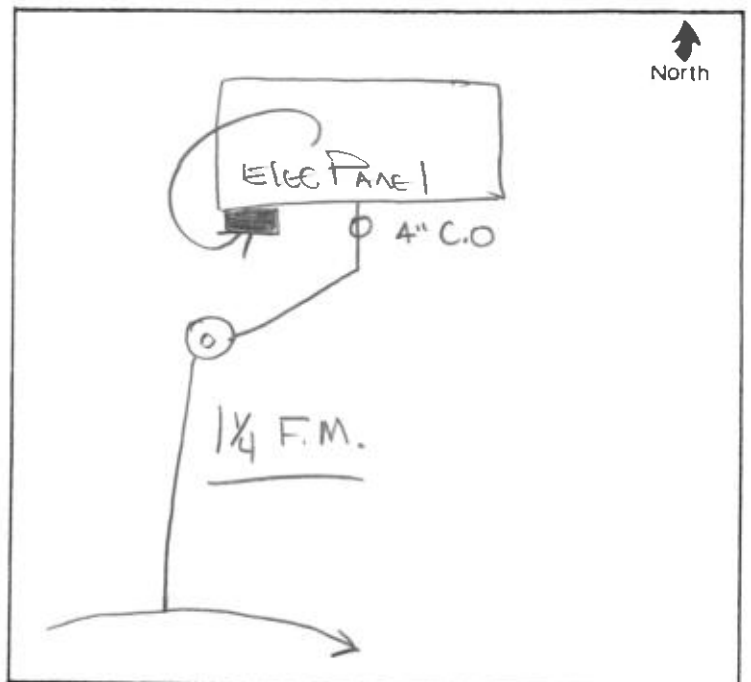

LONG & KOFFER, INC.  
1795 W. HUNTSVILLE RD.  
PENDLETON, INDIANA 46064  
765/778-5219

NATIONAL CITY BANK  
INDIANAPOLIS, INDIANA 46255  
20-6740

9/13/2000

PAY TO THE  
ORDER OF

Fall Creek Regional Waste District

\$ 1024.80

One - Thousand Twenty - Four Dollars and \_\_\_\_\_

80/100

DOLLARS

MEMO:

*John G. Allen*

⑈001190⑈ ⑆074000065⑆ 501977276⑈

SECURITY FEATURES: MICRO PRINT TOP & BOTTOM BORDERS - COLORED PATTERN - ARTIFICIAL WATERMARK ON REVERSE SIDE - MISSING FEATURE INDICATES A COPY

RIFFEY BUILDERS INC.

5205 S. 525W

PENDLETON, IN 46064-9174

71-553/749  
7903383

833

DATE 9-13-00

PAY TO THE  
ORDER OF

Fall Creek Waste

\$ 2556<sup>00</sup>

Two Thousand Five Hundred Fifty Six<sup>00</sup>

DOLLARS  Security feature  
included.  
Details on back



Madison  
Community Bank

MEMO \_\_\_\_\_

Robert R. [Signature]

⑆074905539⑆ 790 338 3⑈ 0833

SAFETY PAPER