



FALL CREEK REGIONAL WASTE DISTRICT

9378 S. 650 West PO Box 59
Pendleton, IN 46064-0059 778-7544

add order
on file

8-18530.00

8-18530.00

APPLICATION FOR SEWER PERMIT

Nº 2324

Date 11/28/95

Permit Void 90 days from Date of Issuance

Owner Name William Redding

Property Address 631 N Pendleton Ave

Lot # _____ P.O. Box _____

Town Pendleton, IN Zip Code 46064

Phone _____ City Water _____ Well _____

\$ 700.00 2/2/96 Tap on Fee Paid 175.00 2/2/96 P

\$ 25.00 2/2/96 Inspection fee paid pd 900 3/14/96 = 525P, 375L
pd 900 4/2/96 = 900L

Application is hereby made for connection to the Fall Creek Regional Waste District Sewer System for the above listed property - Permit Type: Residential _____, Commercial _____, Industrial _____, or Governmental/Institutional _____. User Information _____.

All workmanship and materials shall conform to the standards of the District Ordinance as described in Ordinance 84-2 and 84-3 as amended. Acceptance and approval must be made by the District inspector or his duly authorized representative before backfilling and final connection is made to the main sewer lines. Any violation of applicable regulations will cause all lines and appurtenances in violation to be removed and replaced at the owners expense.

The Fall Creek Regional Waste District is responsible for the inspection, approval of materials, and installation techniques only. All costs for materials and installation and any liabilities resulting from same is the sole responsibility of the property owner.

I have read and fully understand the above provisions and agree to comply by said provisions.

APPLICANT(S) SIGNATURE

INSPECTOR DW

Date inspected 11-23-95 Approved ✓ Rejected _____

Reason for rejection _____

Date reinspected _____ Approved _____ Rejected _____

Notes:

Size Pipe 4"

Type Pipe PVC

Basement Yes _____ No ✓

Sump Pump Yes _____ No ✓

Downspout to Ground Yes ✓ No _____


Septic Tank Pumped & filled Yes _____ No _____

Contractor TONY SHANNON

Special Conditions _____

Existing Home ✓

New Construction _____

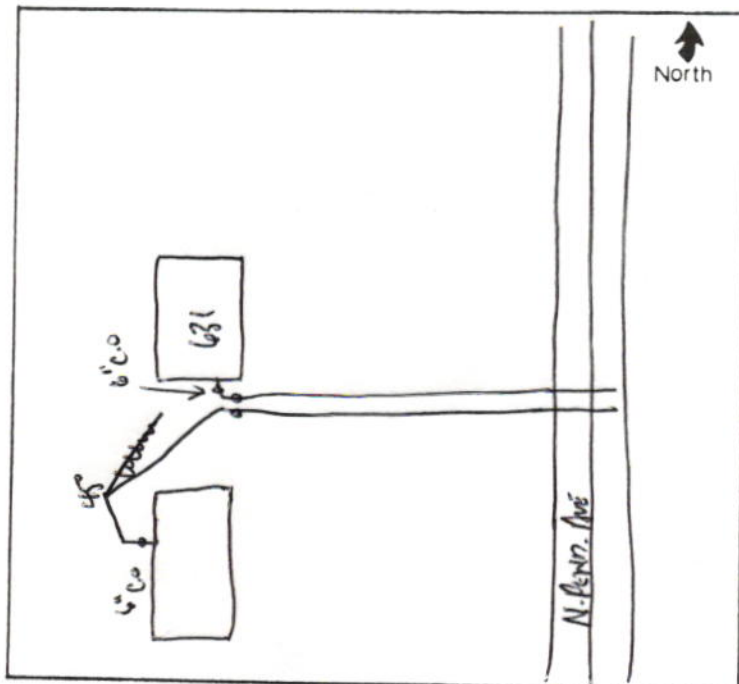



FALL CREEK REGIONAL WASTE DISTRICT

9378 S. 650 West PO Box 59
Pendleton, IN 46064-0059 778-7544

add order
on file

APPLICATION FOR SEWER PERMIT

Nº 2324

Date 11/28/95

Permit Void 90 days from Date of Issuance

Owner Name William Redding

Property Address 631 N Pendleton Ave

Lot # _____ P.O. Box _____

Town Pendleton, IN Zip Code 46064

Phone _____ City Water _____ Well _____

\$ 700.00 3/2/96 Tap on Fee Paid 175.00 3/2/96 plant

\$ 25.00 3/2/96 Inspection fee paid pd 900 3/14/96 325 plant 375 line
pd 900 4/2/96 line

Application is hereby made for connection to the Fall Creek Regional Waste District Sewer System for the above listed property - Permit Type: Residential _____, Commercial _____, Industrial _____, or Governmental/Institutional _____. User Information _____.

All workmanship and materials shall conform to the standards of the District Ordinance as described in Ordinance 84-2 and 84-3 as amended. Acceptance and approval must be made by the District inspector or his duly authorized representative before backfilling and final connection is made to the main sewer lines. Any violation of applicable regulations will cause all lines and appurtenances in violation to be removed and replaced at the owners expense.

The Fall Creek Regional Waste District is responsible for the inspection, approval of materials, and installation techniques only. All costs for materials and installation and any liabilities resulting from same is the sole responsibility of the property owner.

I have read and fully understand the above provisions and agree to comply by said provisions.

APPLICANT(S) SIGNATURE

INSPECTOR Dan

Date inspected 11-28-95 Approved ✓ Rejected _____

Reason for rejection _____

Date reinspected _____ Approved _____ Rejected _____

Notes:

Size Pipe 4 "

Type Pipe PVC

Basement Yes _____ No ✓

Sump Pump Yes _____ No ✓

Downspout to Ground Yes ✓ No _____


Septic Tank Pumped & filled Yes _____ No _____


Contractor Tony Sanders

Special Conditions _____

Existing Home ✓

New Construction _____

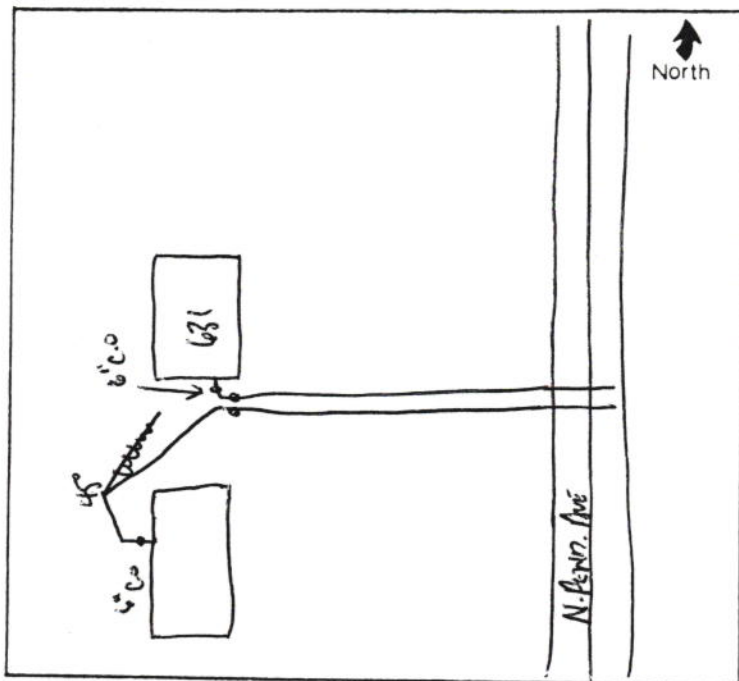

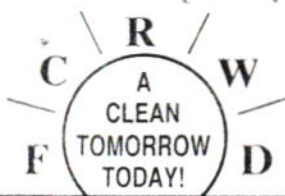

FALL CREEK REGIONAL WASTE DISTRICT

P.O. Box 59 • 9378 S. 650 West • Pendleton, Indiana 46064-0059 • (317) 778-7544

January 24, 1996

Mr. Wm. Redding
631 N. Pendleton Avenue
Pendleton, IN 46064

RE: Sanitary sewer connection fees

Dear Mr. Redding:

The purpose of this letter is to notify you of our sanitary sewer connection fees. Normally, when we extend our sanitary sewer lines into a new area, we send connect notices to the affected residents explaining connect procedures and fees. However, your residence was connected before we sent notices to your area.

There is a \$2700 residential tap-on fee and a \$25 inspection fee payable upon receipt of this notice. Payment may be made at our Administrative Office, 9378 S County Road 650 West, Pendleton, Indiana 46064. A Time Payment Plan is available for this fee. If you are interested in the details of the Time Payment Plan, please call our Office Manager at 778-7544.

We look forward to hearing from you.

Sincerely,


Joe F. Rowlett
General Manager