




PROJECT Phase II SHEET _____ OF _____
SUBJECT _____ DATE 4-26-18
JOB NO. 4447
BY AHAS

631 S. BROADWAY

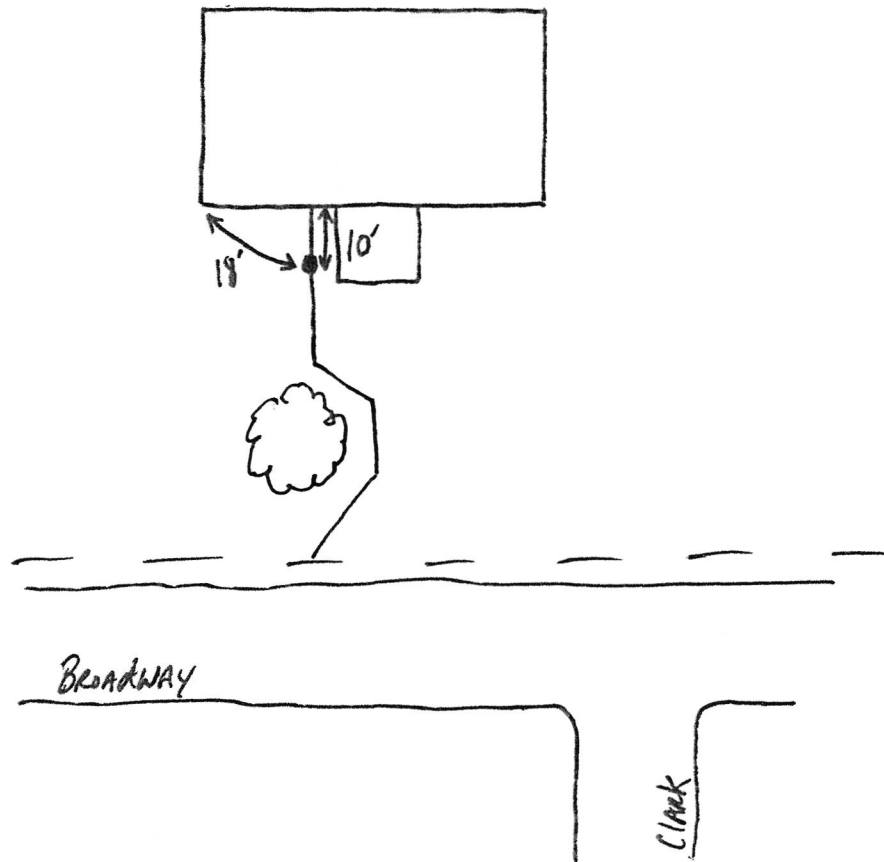

631 S Broadway

SAP
Phase II

5.3.18

