

add order  
on file



FALL CREEK REGIONAL WASTE DISTRICT

9378 S. 650 West PO Box 59  
Pendleton, IN 46064-0059 778-7544

26-08150.00

No 2713

APPLICATION FOR SEWER PERMIT

Date 10/27/99

Permit Void 90 days from Date of Issuance

Owner Name Jay Ricker

Property Address 6320 Fosters Branch Drive

Lot # 16, Fosters Branch Woods P.O. Box

Town Pendleton, IN Zip Code 46064

Phone City Water Well ☒

\$ 400 Tap on Fee Paid

\$ 2156 Capacity inspection fee paid

Application is hereby made for connection to the Fall Creek Regional Waste District Sewer System for the above listed property - Permit Type: Residential ☒, Commercial ☐, Industrial ☐, or Governmental/Institutional ☐. User Information

All workmanship and materials shall conform to the standards of the District Ordinance as described in Ordinance 84-2 and 84-3 as amended. Acceptance and approval must be made by the District inspector or his duly authorized representative before backfilling and final connection is made to the main sewer lines. Any violation of applicable regulations will cause all lines and appurtenances in violation to be removed and replaced at the owners expense.

The Fall Creek Regional Waste District is responsible for the inspection, approval of materials, and installation techniques only. All costs for materials and installation and any liabilities resulting from same is the sole responsibility of the property owner.

I have read and fully understand the above provisions and agree to comply by said provisions.

APPLICANT(S) SIGNATURE

\*\*\*\*\*


INSPECTOR Rie

Date inspected 10-27-99 Approved ☒ Rejected ☐

Reason for rejection

Date reinspected Approved Rejected

Notes:  
Size Pipe 4" "  
Type Pipe PVC  
Basement Yes ☒ No ☐  
Sump Pump Yes ☒ No ☐  
Downspout to Ground Yes ☒ No ☐  
Septic Tank Pumped & filled Yes ☐ No ☒  
Contractor M + M  
Special Conditions  
Existing Home  
New Construction ☒

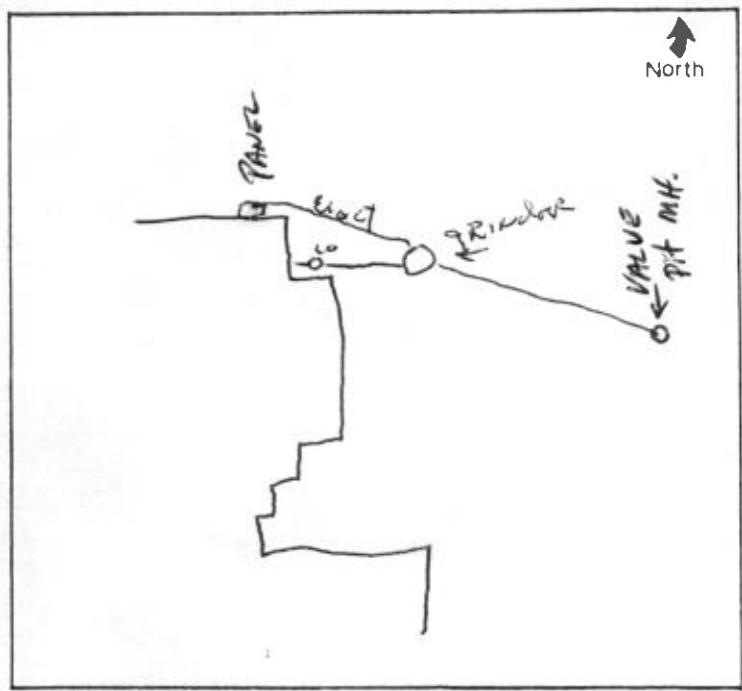



CAMPBELL CUSTOM HOMES, INC.

5640 APPLE CREEK WAY APT. H  
ANDERSON, IN 46013

71-553/749  
7005105

2170

DATE 10/27/90

PAY TO THE  
ORDER OF

Full Creek Regional Home \$2556.<sup>xx</sup>  
Twenty five hundred fifty six <sup>xx</sup>

DOLLARS

 Security Features  
recording  
Details on back.



Madison  
Community Bank

MEMO

Lofile TAR-fer

Scott Blaylock

MP

⑆074905539⑆ 700 510 511 2170

SAFETY PAPER