

add order
on file



FALL CREEK REGIONAL WASTE DISTRICT

9378 S. 650 West PO Box 59
Pendleton, IN 46064-0059 778-7544

22-40025.00

APPLICATION FOR SEWER PERMIT

Nº 2527

Date 7-13-98

Permit Void 90 days from Date of Issuance

Owner Name Bob Taylor (378-7556) *Steven meavoy*

Property Address 6330 S Lorry Lane

Lot # 136 - Fiddler's Green P.O. Box _____

Town Pendleton, IN Zip Code 46064

Phone _____ City Water _____ Well ☒

\$ 400 Tap on Fee Paid 11/3/98

\$ 2156 *capacity* ~~Inspection~~ fee paid 11/3/98

Application is hereby made for connection to the Fall Creek Regional
Waste District Sewer System for the above listed property - Permit Type:
Residential ☒, Commercial _____, Industrial _____, or Governmental/
Institutional _____. User Information _____.

the
duly
made
l
aced
inspection,
for
the
to

*Said tap fee is in escrow
pending outcome of law
suit*

J


INSPECTOR *Don*

Date inspected 7-13-98 Approved ☒ Rejected _____

Reason for rejection _____

Date reinspected _____ Approved _____ Rejected _____

Notes:
Size Pipe 6"
Type Pipe PVC
Basement Yes _____ No ☒
Sump Pump Yes _____ No ☒
Downspout to Ground Yes ☒ No _____
Septic Tank Pumped & filled Yes ☒ No _____
Contractor Don Brown
Special Conditions NO TAP FEE
LAW SUIT PENDING
Existing Home _____
New Construction ☒

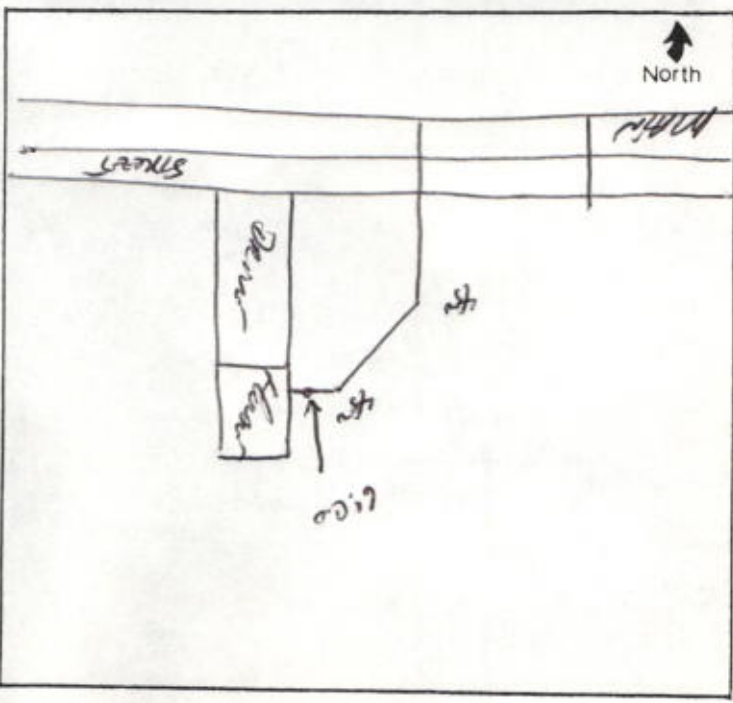

FALL CREEK REGIONAL WASTE DISTRICT

301 E. 4th Street, Box 20
Tulsa, Oklahoma 74101-0020 918-581-2244



22-11002100

2551

REGISTRATION FOR WASTE TREATMENT

7-13-98

DATE

PERMIT NO. OR CASE NO. OF TREATMENT

OWNER NAME

Bob Taylor

PROPERTY ADDRESS

0300 2 Larry Lane

LOT # 136 - 6th Street

TYPE OF TREATMENT

11/10/98

PHONE

City Water

1. TOP OF THE TANK

11/10/98

2. BOTTOM OF THE TANK

11/10/98

NOTIFICATION: The owner is hereby notified that the Fall Creek Regional Waste District is required to inspect the above listed property. Failure to permit inspection may result in the district taking action to enforce the provisions of the Oklahoma Solid Waste Act, Title 101, Section 10-101.

ALL WORKMANSHIP AND MATERIALS shall conform to the standards of the Oklahoma Department of Environmental Quality. The district reserves the right to require additional testing and analysis of materials and waste. The district reserves the right to require the owner to provide access to the site for inspection and testing. The district reserves the right to require the owner to provide a copy of the permit to the district.

The Fall Creek Regional Waste District is responsible for the inspection, approval of materials, and installation of the waste treatment system. The district reserves the right to require the owner to provide a copy of the permit to the district.

I have read and fully understand the above provisions and agree to comply with said provisions.

WASTE TREATMENT SYSTEM


THOMAS

11/10/98

DATE

11/10/98

11/10/98

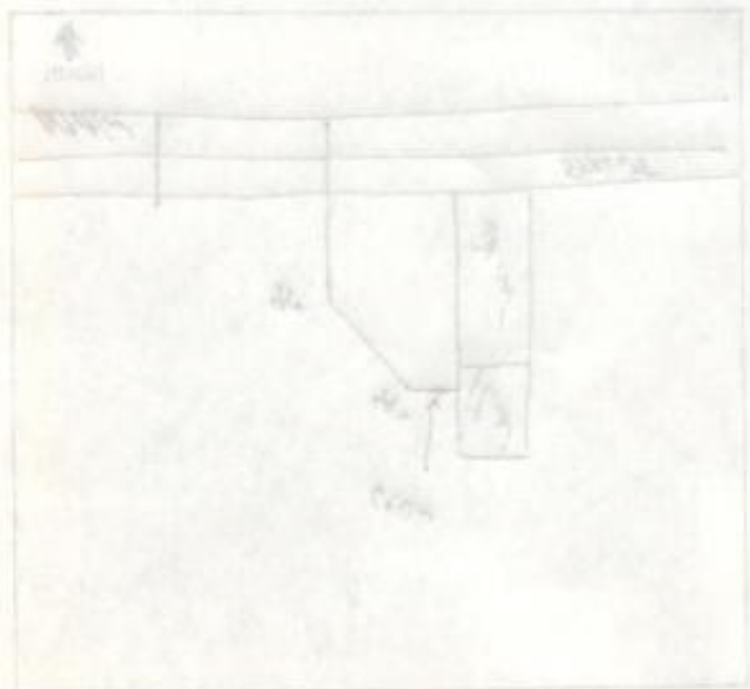

1. TOP OF THE TANK
2. BOTTOM OF THE TANK
3. WASTE TREATMENT SYSTEM
4. WASTE TREATMENT SYSTEM
5. WASTE TREATMENT SYSTEM
6. WASTE TREATMENT SYSTEM
7. WASTE TREATMENT SYSTEM
8. WASTE TREATMENT SYSTEM
9. WASTE TREATMENT SYSTEM
10. WASTE TREATMENT SYSTEM