

Fall Creek Regional Waste District
9378 S 650 W, P.O. Box 59, Pendleton, IN 46064
765-778-7544

#6449

Agreement for Sanitary Sewer ServiceJeff & Tammy
Carey

This Agreement made and entered into this 25 day of September 2012, between Fall Creek Regional Waste District ("District") and Red Holloway Homes ("Applicant") regarding the provision of sanitary sewer service, and the assignment of capacity in and connection to, the District's facilities for the premises located at Jefferson Place Lot 31
6334 S Supreme

Now therefore, the parties, in consideration of the mutual promises set out in this Agreement, the receipt and sufficiency of which is hereby acknowledged, agree as follows:

1. The Applicant agrees that all workmanship and materials shall conform to all District ordinances and the District's construction standards. District must accept and approve all work and materials before backfilling and final connection is made to the sewer mains. Any violation of this provision will cause all lines and appurtenances in violation to be removed and replaced at the Applicant's expense.
2. The District shall have the right to enter upon the Applicant's premises at all reasonable times to inspect, repair, or replace any equipment used in connection with the District's service or which has an impact on said service.
3. The Applicant shall be responsible for all monthly user rates, capacity charges, and tap fees. The failure to pay any rate charge or fee may result in a lien against the property and/or the termination of service to the property, the cost of which will be borne by Applicant, including, but not limited to, all attorney's fees and collection costs.
4. The District shall not be responsible for any damages as a result of any failure to supply service unless said damages are due to default, neglect or culpability on the part of the District.
5. If there is an available sanitary sewer within three hundred (300) feet of the property line, the property owner shall be required to connect to the District's sanitary sewer system.
6. The Applicant and District agree that the provision of sanitary sewer service touches and concerns the property and the terms of this Agreement bind the District and Applicant and their heirs, executors, administrators, personal representatives, successors, agents, attorneys, assigns, designees, and transferees.

The parties hereto have read and fully understand the above provisions and agree to comply with said provisions.

FALL CREEK REGIONAL WASTE DISTRICT

Rebecca Lynn Hunter
Signature

APPLICANT

Reddy P. Holloway
Signature

STATE OF INDIANA)
) SS:
COUNTY OF MADISON)

SUBSCRIBED and sworn to before me this 25 day of September 2012

My Commission Expires:



Commission Expires November 20, 2015
A Resident of
Hamilton County, Indiana
Rebecca Lynn Hunter, Notary Public

Signature

Printed

Rebecca Lynn Hunter

Rebecca Lynn Hunter
Notary Public

Resident of Hamilton County

Inspector SN Date Inspected 11/2/12 Approved ☒ Rejected ☐

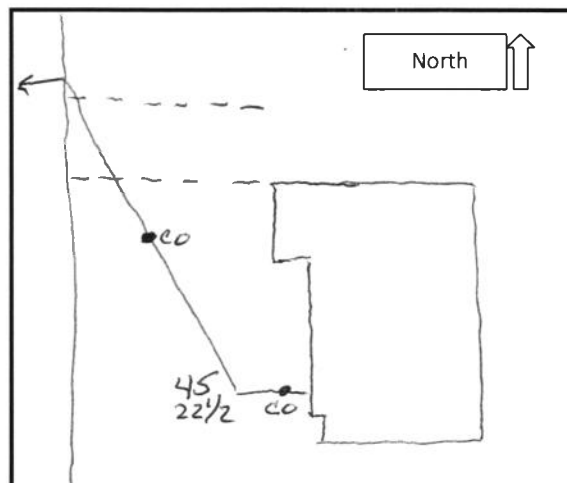
Reason for Rejection _____
Date Reinspected _____ Approved ☐ Rejected ☐

Notes:

Size Pipe 6" Type Pipe 35Basement Yes NoSump Pump Yes NoDownspout to Ground Yes NoSeptic Tank Pumped & Filled Yes NoContractor B.L. BROWN

Special Conditions _____

Existing Home _____

New Construction ☒

Commission Expires November 30, 2012
A Resolution of
Hamilton County, Indiana
Rebecca Lynn Hamer, Mayor, 100116



ROD HOLLOWAY HOMES, INC.

765-208-0244
325 E. 1000 S.
PENDLETON, IN 46064

PNC BANK, N.A.
70-2189/719

3740

9-25-12

PAY TO THE
ORDER OF

Fall Creek Regional Waste District

\$ 3370.00

Three thousand three hundred seventy and - ⁰⁰/₁₀₀ DOLLARS

MEMO Jefferson Place Lot #31

Roddy P. Holloway

AUTHORIZED SIGNATURE

⑈003740⑈ ⑆071921891⑆ 4622341211⑈

Details on Back

Security Features Included

COPY

COPY