

FALL CREEK REGIONAL WASTE DISTRICT

9378 S 650 WEST, P.O. BOX 59, PENDLETON, IN 46064

765-778-7544

AGREEMENT FOR SANITARY SEWER SERVICE

add order  
on file

4432

26-04470.00

This Agreement made and entered into this 13<sup>th</sup> day of June, 2001, between FALL CREEK REGIONAL WASTE DISTRICT ("District") and John Hanson ("Applicant") regarding the provision of sanitary sewer service, and the assignment of capacity in, and connection to, the District's facilities for the premises located at 6336 White Oaks Dr.

**NOW THEREFORE**, the parties, in consideration of the mutual promises set out in this Agreement, the receipt and sufficiency of which is hereby acknowledged, agree as follows:

1. The Applicant agrees that all workmanship and materials shall conform to all District ordinances and the District's construction standards. District must accept and approve all work and materials before backfilling and final connection is made to the sewer mains. Any violation of this provision will cause all lines and appurtenances in violation to be removed and replaced at the Applicant's expense.
2. The District shall have the right to enter upon the Applicant's premises at all reasonable times to inspect, repair, or replace any equipment used in connection with the District's service or which has an impact on said service.
3. The Applicant shall be responsible for all materials and tap fees. The failure to pay any rate charge or fee may result in a termination of service to the property, the cost of which will be borne by Applicant, including the District's fees and collection costs.
4. The District shall not be responsible for a supply service unless said damages are due to default, neglect or culp
5. If there is an available sanitary sewer within three feet of the property line, the property owner shall be required to connect to the District's sanitary sewer system.
6. The Applicant and District agree that the provision of sanitary sewer service touches and concerns the property and the terms of this Agreement bind the District and Applicant and their heirs, executors, administrators, personal representatives, successors, agents, attorneys, assigns, designees, and transferees.

Put in  
Bens  
mailbox  
6-13-01

The parties hereto have read and fully understand the above provisions and agree to comply with said provisions.

FALL CREEK REGIONAL WASTE DISTRICT

APPLICANT

Signature

Signature

STATE OF INDIANA )

) SS:

COUNTY OF MADISON )

SUBSCRIBED and sworn to before me this \_\_\_\_\_ day of \_\_\_\_\_, 200\_\_.

My Commission Expires:

Signature

Printed

Notary Public  
Resident of Madison County

\*\*\*\*\*  
INSPECTOR B DATE INSPECTED 6-13-01 APPROVED ✓ REJECTED \_\_\_\_\_

REASON FOR REJECTION \_\_\_\_\_

DATE REINSPECTED \_\_\_\_\_ APPROVED \_\_\_\_\_ REJECTED \_\_\_\_\_

NOTES:

SIZE PIPE 6 TYPE PIPE 26

BASEMENT YES \_\_\_\_\_ NO X

SUMP PUMP YES \_\_\_\_\_ NO X

DOWNSPOUT TO GROUND YES X NO \_\_\_\_\_


SEPTIC TANK PUMPED & FILLED YES X NO \_\_\_\_\_

CONTRACTOR Gerry

SPECIAL CONDITIONS \_\_\_\_\_

EXISTING HOME X

NEW CONSTRUCTION \_\_\_\_\_

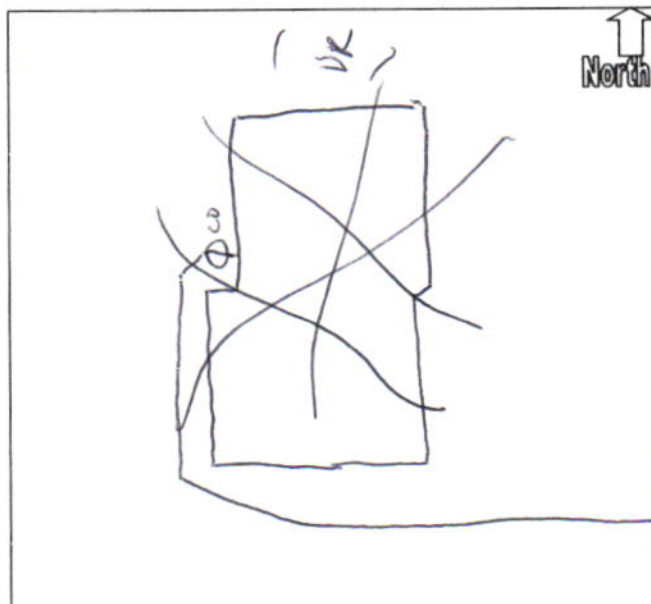

\_\_\_ DATE INSPECTED \_\_\_ APPROVED \_\_\_ REJECTED \_\_\_

OR REJECTION \_\_\_\_\_

DATE REINSPECTED \_\_\_ APPROVED \_\_\_ REJECTED \_\_\_

NOTES:

SIZE PIPE \_\_\_\_\_ TYPE PIPE \_\_\_\_\_

BASEMENT YES \_\_\_\_\_ NO \_\_\_\_\_

SUMP PUMP YES \_\_\_\_\_ NO \_\_\_\_\_

DOWNSPOUT TO GROUND YES \_\_\_\_\_ NO \_\_\_\_\_

SEPTIC TANK PUMPED & FILLED YES \_\_\_\_\_ NO \_\_\_\_\_

CONTRACTOR \_\_\_\_\_

SPECIAL CONDITIONS \_\_\_\_\_

EXISTING HOME \_\_\_\_\_

NEW CONSTRUCTION \_\_\_\_\_

