

DD-139810-00

№ 5656

765-778-7544

AGREEMENT FOR SANITARY SEWER SERVICE

Allen, Peggy

This Agreement made and entered into this 9th day of August, 2005, between FALL CREEK REGIONAL WASTE DISTRICT ("District") and Price Builders, Inc. ("Applicant") regarding the provision of sanitary sewer service, and the assignment of capacity in, and connection to, the District's facilities for the premises located at Fiddlers Green lot 141, 222 S.W. 11th St., Ft. Lauderdale, FL 33304.

NOW THEREFORE, the parties, in consideration of the mutual promises set out in this Agreement, the receipt and sufficiency of which is hereby acknowledged, agree as follows:

1. The Applicant agrees that all workmanship and materials shall conform to all District ordinances and the District's construction standards. District must accept and approve all work and materials before backfilling and final connection is made to the sewer mains. Any violation of this provision will cause all lines and appurtenances in violation to be removed and replaced at the Applicant's expense.

2. The District shall have the right to enter upon the Applicant's premises at all reasonable times to inspect, repair, or replace any equipment used in connection with the District's service or which has an impact on said service.

3. The Applicant shall be responsible for all monthly user rates, capacity charges, and tap fees. The failure to pay any rate charge or fee may result in a lien against the property and/or the termination of service to the property, the cost of which will be borne by Applicant, including, but not limited to, all attorney's fees and collection costs.

4. The District shall not be responsible for any damages as a result of any failure to supply service unless said damages are due to default, neglect or culpability on the part of the District.

5. If there is an available sanitary sewer within three hundred (300) feet of the property line, the property owner shall be required to connect to the District's sanitary sewer system.

6. The Applicant and District agree that the provision of sanitary sewer service touches and concerns the property and the terms of this Agreement bind the District and Applicant and their heirs, executors, administrators, personal representatives, successors, agents, attorneys, assigns, designees, and transferees.

The parties hereto have read and fully understand the above provisions and agree to comply with said provisions.

FALL CREEK REGIONAL WASTE DISTRICT
Lillian Wilson
Signature

APPLICANT

Signature _____

[illegible]

SUBSCRIBED and sworn to before me this 9 day of August, 2005

My Commission Expires: _____

2-20-2008

Signature

Printed

Notary Public

Resident of Madison County

INSPECTOR SN DATE INSPECTED 2/16/06 APPROVED ✓ REJECTED

REASON FOR REJECTION

DATE REINSPECTED	APPROVED	REJECTED
------------------	----------	----------

NOTES: SIZE PIPE 16" TYPE PIPE 35

BASEMENT YES NO

SUMP PUMP YES NO

DOWNSPOUT TO GROUND YES NO


SEPTIC TANK PUMPED & FILLED YES NO

CONTRACTOR Zorn Davis

SPECIAL CONDITIONS

EXISTING HOME

NEW CONSTRUCTION ✓

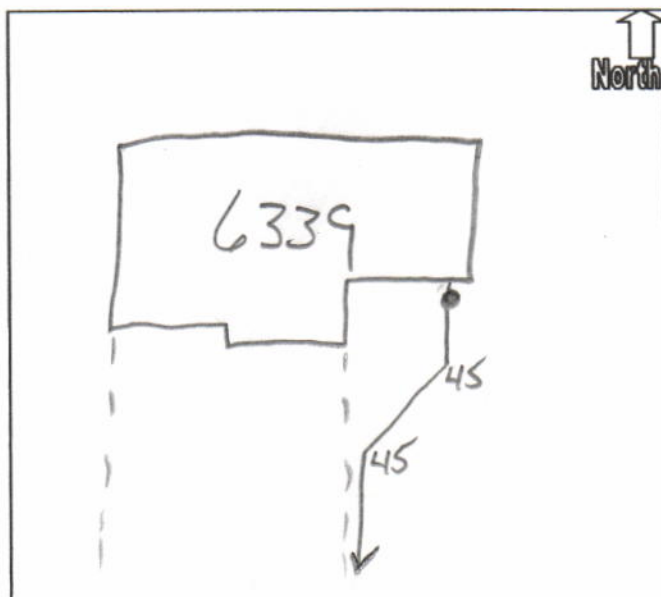



PRICE BUILDERS, INC.
4027 COLUMBUS AVE.
ANDERSON, IN 46013

6044-8521

14632

DATE 8/9/05

71-553/749

PAY
TO THE
ORDER OF

Fall Creek Regional Waste District

\$2635.⁰⁹/₁₀₀

Six thousand Six hundred Thirty Five and 09/100 DOLLARS



Madison
Community Bank

FOR

Power Tap 141 Fiddlers Green

Sam R. Price

⑈014632⑈ ⑆074905539⑆