


Gidw.

PROJECT Phase II SHEET _____ OF _____
SUBJECT _____ DATE 6-14-18
JOB NO 4447
BY Atlas

633 S. Center

← N

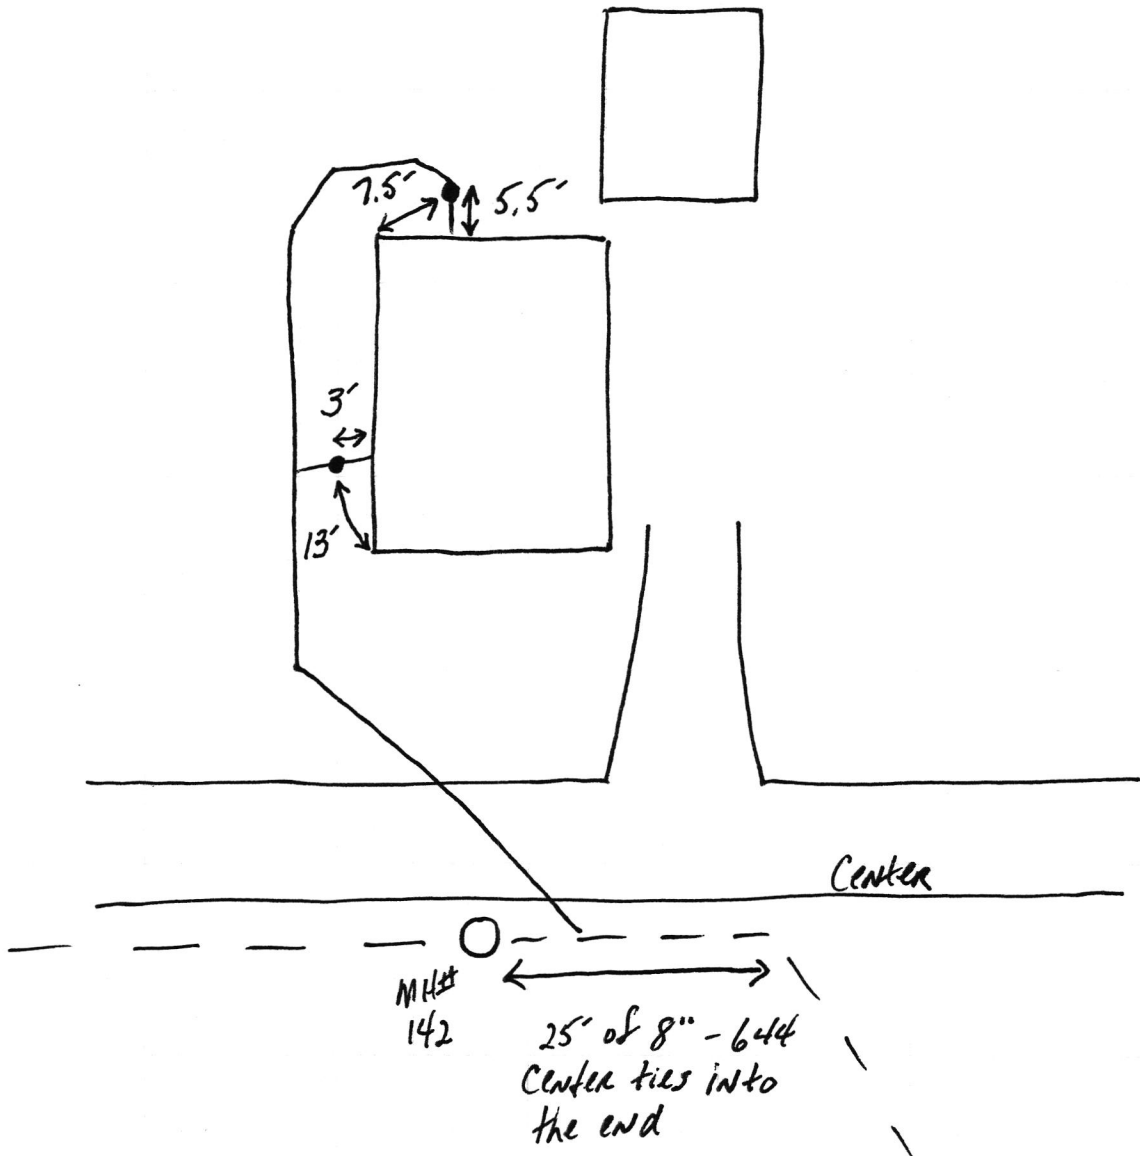

Q33 Center

SPT Phase II

Q-21.18



L33 Center

Sqf Phase II

6.19.18

